


Section 25 Township 13 Range 22W

Well No. #1 Lindsay

Company Doley Oil & Wakefield et al

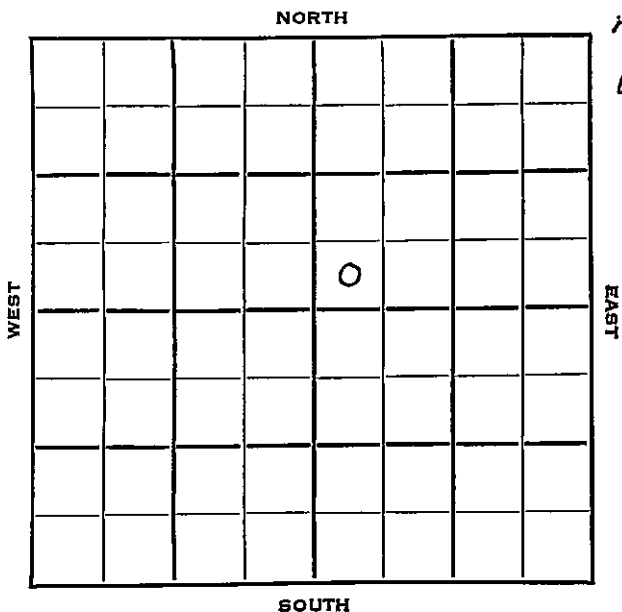

Trego

KANSAS

SEC.	TWP.	R.
25	13	22 W

WELL NO.

1 Lindsey

FARM

COMPANY

Doley Oil & Wakefield et al

CONTRACTOR

Trans-Era
Wildcat


_____ Ft. from N. Line

330 _____ Ft. from S. Line

_____ Ft. from E. Line

330 _____ Ft. from W. Line

SW SW NE

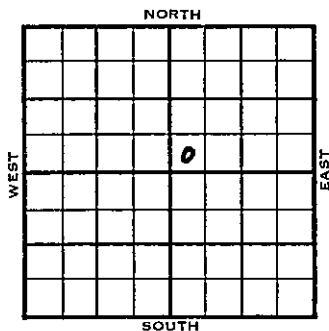

1953	ELEVATION	REPORT
	2356'	

9/23

MIM

9/30

8" @ 209'
Anhy 1765'
Dr1g 3650'

10/7

Spud 9-21-53 D & A TD 4302
8" @ 209 Anhy 1765 Top 3431'
Heeb 3673' Lans 3709' Cong 4109'
DST 4117-43, open 1 hr rec 20' mud
Arb. 4249' TD 4302'
D & A**ABANDONED**

County **Trego** State **Kansas**

Sec. **25** (Blk. **13**) (Sur. **22W**) (Twp.) (Rge.) Map No.

Operator **Doley Oil & Wakefield etal.**

Well No. **1** Farm **Lindsay**

Elev. Location **SW SW NE**

330 Ft. From **S** Line **NE**

330 Ft. From **W** Line **Quarter**

1st. Report **SEP 23 1953**

Completion

Remarks

Trans-Era - Contr.

Spudding Date

Drlg. Data **Wildcat**

M I M

J. G. McGEHEE

