


Section 2 Township 28 Range 5-E

Well No. 1 Hopkins

Company Westgate-Greenland et al

Miscellaneous

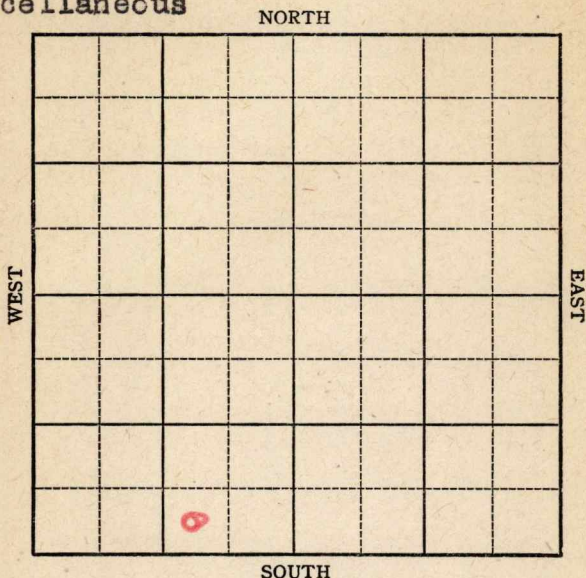

Sec. 2 Twp. 28 **KANSAS** R. 5-E

Well No. #1 Hopkins Farm

Westgate-Greenland etal Company

Miscellaneous

 Ft. from N. Line


330

 Ft. from S. Line

990

 Ft. from E. Line

 Ft. from W. Line

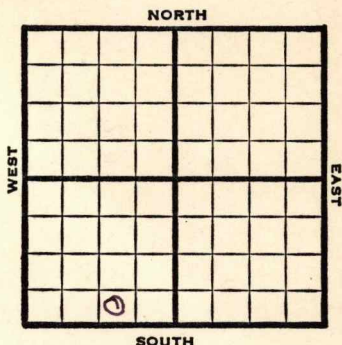

SW SE SW

1947

Elev. 1333' REPORT

7/2

Location

7/8

8" @ 410'
WOC

7/16

Lansing 1850'
Drlg 2125'

7/22

Mississippi 2760
Drlg. 2978

7/30

Simp. 3163'
Arb. 3194'
TD 3246'

ABANDONED

Map No. _____ Sec. 2 Twp. 28 R. 5E

Well No. 1 Hopkins

Westgate-Greenland et al. Company

FIRST REPORT

Contractor _____

SW ~~SE~~ SW

SECTION PLAT

_____ Ft. from N. Line

330 Ft. from S. Line

990 Ft. from E. Line

_____ Ft. from W. Line

Butler County

RECORD

Location X

Cased _____ in., _____ ft.

Rig up _____

Sand _____

Drilling and Remarks:

Gas _____

Oil _____

Total Depth _____

PRODUCTION

1st 24 hrs. Nat. _____

1st 24 hrs. after shot _____

Gas _____ Cu. Ft.

Dry Hole _____

Abandoned _____

Date

JUL 2 1947 19 _____ S. J. LEWIS Scout

Map No. 11 Sec. 2 Twp. 28 R. 5E

Well No. 1 Hopkins

Westgate-Greenland Company

ABANDONED Contractor

SW SE SW

E 1. 1993
SECTION PLAT

 Ft. from N. Line

330 Ft. from S. Line

990 Ft. from E. Line

 Ft. from W. Line

Butler County

Location

Rig up

Drilling and Remarks:

Ding 8/63
Cr 83194

RECORD

Cased in., ft.

Sand

Gas

Oil

Total Depth 3246

PRODUCTION

1st 24 hrs. Nat.

1st 24 hrs. after shot

Gas Cu. Ft.

Dry Hole

Abandoned

Date

JUL 30 1947 19

S. J. LEWIS

Scout