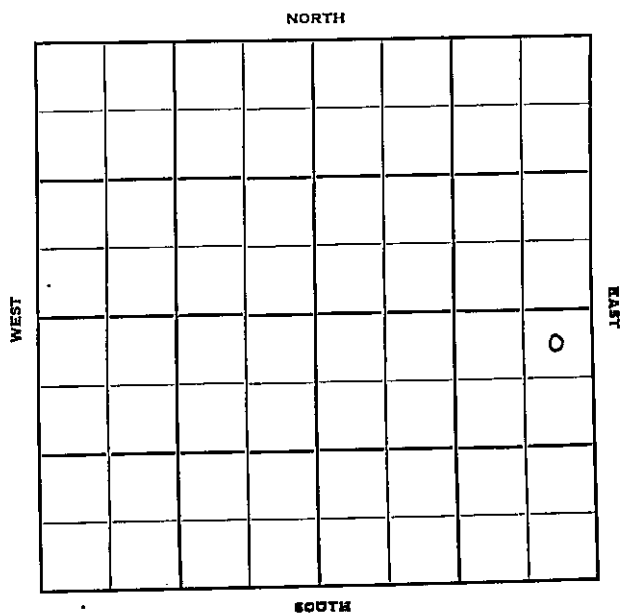


Section 17 Township 13 Range 23 WWell No. # 1 BenderCompany Anchultz Drlg.

Trego

KANSAS

Sec. 17 Twp. 13 R. 23 W ✓

Well No. # 1 Bender Farm

Anschultz Drlg. Company

Contractor

Wildcat


330 Ft. from N. Line

 Ft. from S. Line

330 Ft. from E. Line

 Ft. from W. Line

NE NE SE

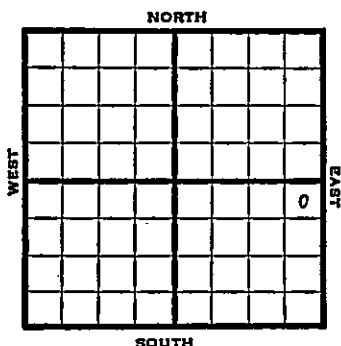

1951

Elev. 2433' REPORT

10/10

Location

11/7

Spud 10-11-51

D&A TD 4635

8" @ 212'

Anhy 1830'

Ft. Riley 2500

Top. 3548

Heeb. 3764

Tor. 3777

Ians. 3795

B KC 4048

Marm. 4161

Miss. 4360

Viola 4491


Arb. 4583

TD 4635

D&A

ABANDONED

County **Trego** State **Kansas**
 Sec. **17** (Blk.) **13** (Sur.) **23W** Map No.
 Operator **Anchultz Drlg.**
 Well No. **1** Farm **Bender**
 Elev. Location **NE NE SE**

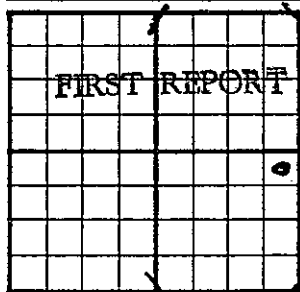

330 Ft. From **N** Line **SE**
330 Ft. From **E** Line Quarter

Ist. Report **OCT 10 1951**

Completion


Remarks

Spudding Date

Drlg. Data **Wildcat**

Location

J. E. TYRA

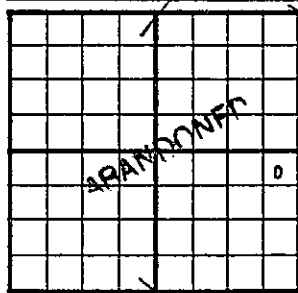County Trego State KansasSec. 17 (Blk. 13) (Sur. 23W) Map No. 13Operator Anschutz Drlg.Well No. 1 Farm BenderElev. 2433 Location NE NE SE330 Ft. From N Line SE330 Ft. From E Line Quarter1st. Report Completion NOV 7 1951Remarks WildcatSpudding Date 10-11-51Drlg. Data D & A TD 46358" @ 212 Anhy 1830 Ft. Riley 2500Top. 3548 Heeb. 3764 Tor. 3777Lans. 3795 B KC 4048 Marm. 4161Miss. 4360 Viola 4491 Arb. 4583TD 4635 D & A