

Section 3 Township 28 Range 5-E

Well No. #1 Clark

Company Crowell & Lewis

NORTH

Miscellaneous

							0

WEST

EAST

SOUTH

Sec. 3 Twp. 28 R. 5-E

Well No. #1 Clark Farm

Crowell & Lewis Company


(Misc.)

320 Ft. from N. Line

_____ Ft. from S. Line

370 Ft. from E. Line

_____ Ft. from W. Line

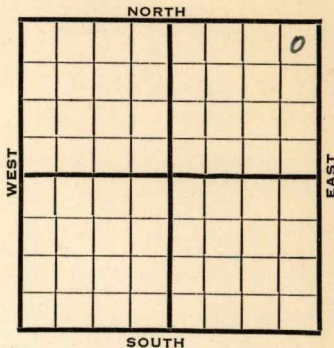

Elev. 1277

1940	REPORT
4/17	Machine. 12" - 942' Drlg. 1225'
4/26	Drlg. 1720'
5/2	Drlg. 2250'
5/9	K. C. 2095' 8" - 2140' Burgess 2650' 6" - 2648' Drlg. 2670'
5/16	Miss. 2676' Drlg. 2780'
5/23	B. Miss. 2993' 5" - 3066' Simp. 3078' SO 3081-83' T.D. 300' oil 12 hours. P.B.P.
5/29	" " " " "
6/6	" " " " "
6/12	Simpson sand 3078' 5" - 3066' T.D. 3086' Pump 38 bbls.
	COMPLETED

Map No. 11 Sec. 3 Twp. 28 R. 5E

Well No. 1 Clark

Crowell & Lewis Company

Contractor

FIRST REPORT

NE/C

320 Ft. from N. Line

_____ Ft. from S. Line

370 Ft. from E. Line

_____ Ft. from W. Line

SECTION PLAT

			0

MISCELLANEOUS

Location _____

Rig up _____

Drilling and Remarks:

Machine
12" - 942
Drlg. 1225

RECORD

Cased _____ in., _____ ft.

Sand _____

Gas _____

Oil _____

Total Depth _____

PRODUCTION

1st 24 hrs. Nat. _____

1st 24 hrs. after shot _____

Gas _____ Cu. Ft.

Dry Hole _____

Abandoned _____

Date

APR 17 1940

S. J. LEWIS Scout

Map No. 11 Sec. 3 Twp. 28 R. 5E

Well No. 1 Clark

Crowell & Lewis Company

Contractor

COMPLETED

SECTION PLAT

NE/C

320 Ft. from N. Line

_____ Ft. from S. Line

370 Ft. from E. Line

_____ Ft. from W. Line

			0

MISCELLANEOUS

Location _____

Rig up _____

Drilling and Remarks:

*Simpson Sol 8078
5" C 9066.*

38 BH's Pump

RECORD

Cased _____ in., _____ ft.

Sand _____

Gas _____

Oil _____

Total Depth 3086

PRODUCTION

1st 24 hrs. Nat. _____

1st 24 hrs. after shot _____

Gas _____ Cu. Ft.

Dry Hole _____

Abandoned _____

Date

JUN 12 1940 19

S. J. LEWIS Scout