


Trego

Form 51-5M-3-35-Mid-West

Map No. KANSAS Sec. 12 Twp. 13 R. 24WWell No. #1 Deines Farm
J.J. Hall Company

NORTH

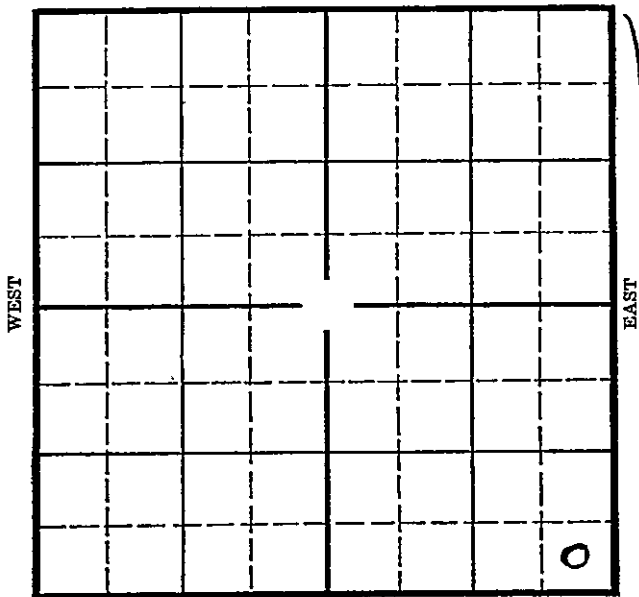

SOUTH

Location
Drilling RemarksRig Up
Drilling Remarks

RECORD

Cased _____ in. _____ ft.

Sand _____

Gas _____

Oil _____

Total Depth _____

PRODUCTION

1st 24 hrs. Nat. _____

1st 24 hrs. after shot _____

Gas _____ cu. ft. _____

Dry Hole _____

Abandoned _____

Map No. _____ Sec. 12 Twp. 13 R. 24-WWell No. 1-Deines Farm _____

J.J. Hall


Company _____

_____ Ft. from N. Line

330 Ft. from S. Line330 Ft. from E. Line

_____ Ft. from W. Line

Elev. 2478

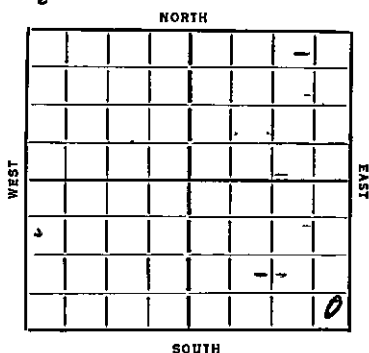Date
1936

REPORT

4/8 Moving in cable tools

4/16 Rigging up.

4/23-- 4/30-- 5/7-- 5/14--

5/21 Spud.

5/28 Drlg. ~~12~~ 815'.

6/4 Drlg. 1100'.

6/11 Drlg. 1390'. 12 $\frac{1}{2}$ " @ 1214'.

6/18 Drlg. 1773'.

6/25 1970'. Under ream 12".

7/2 Drlg. 2120'.

7/9 Drlg. 2670'.

7/16 Drlg. 3045'.

7/23 Drlg. 3121'.

7/30 Drlg. 3450'.

8/6 Dodge 3620'. Drlg. 3700'.

8/13 HFW 3845'. Oswald 3870'. TD 3882'.
Under ream 8".

8/20 Hole full of water @ 3490'. Drlg.
3495'.

8/27 8" @ 3981'. Drlg. 4020'.

9/3 6" @ 4147'. Drlg. 4186'.

OVER

9/10-Conglomerate 4391'. T.D. 4404'.
Under ream 6".

9/18-6" @ 4409'. Drlg. 4410'.

9/24-Hole full of water 4470-48'.
T.D. 4500' fishing.

10/1--~~10/8~~

10/8-Under ream 6".

10/15--

10/22-6" @ 4528'. TD 4740' Shut down.

10/29--

11/4-Miss. L. 4410

4391 4410
2478 2478

Hole Full water 4470 -1913-1932

T. D. 4740

D & A

ABANDONED

Map No. 69 Sec. 12 Twp. 13 R. 24 W.Well No. 1 DeinesJ. J. Hall Company

Contractor

SECTION PLAT

Ft. from N. Line

330 Ft. from S. Line330 Ft. from E. Line

Ft. from W. Line

FIRST REPORT

Location.....

Rig up.....

Drilling and Remarks:

Moving in
Cable tools

RECORD

Cased.....in.,ft.

Sand.....

Gas.....

Oil.....

Total Depth.....

PRODUCTION

1st 24 hrs. Nat.....

1st 24 hrs. after shot.....

Gas.....Cu. Ft.

Dry Hole.....

Abandoned.....

Date

4/8/96 192..... S. J. LEWIS Scout

Map No. 69 Sec. 12 Twp. 19 R. 24WWell No. 18 TeineJ. J. Hall Company
Contractor

SECTION PLAT

			0

 Ft. from N. Line330 Ft. from S. Line330 Ft. from E. Line Ft. from W. Line

ABANDONED

Location Rig up

Drilling and Remarks:

Miss L. 4410HPW 4470JJA

RECORD

Cased in., ft.Sand Gas Oil Total Depth 4740

PRODUCTION

1st 24 hrs. Nat. 1st 24 hrs. after shot Gas Cu. Ft.Dry Hole Abandoned

Date

NOV 4 1936

19

S. J. LEWIS Scout