


Section 3 Township 28 Range 5E

Well No. 3 Clark

Company Rex & Morris et al

Misc.

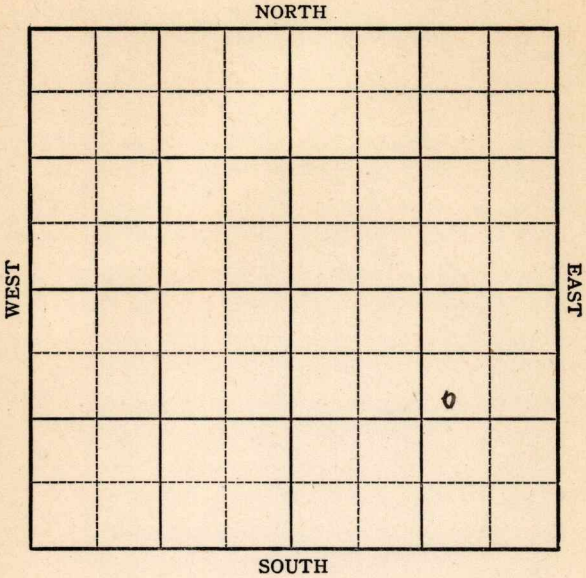

Sec. 3 Twp. 28 R. 5E ✓

Well No. #3 Clark Farm \_\_\_\_\_

Rex & Morris et al Company

Miscellaneous


990' Ft. from N. Line

\_\_\_\_\_ Ft. from S. Line

830' Ft. from E. Line

\_\_\_\_\_ Ft. from W. Line

SW NE SE

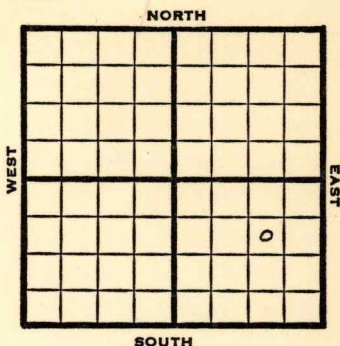

1949

**L<sup>e</sup> lev 1263'**

REPORT

- 3/16 Location
- 3/23 "
- 3/30 "
- 4/6 15" @ 287'  
Drlg. 365'
- 4/12 Drlg. 1232'
- 4/20 10" @ 1820'  
Drlg. 3005'
- 4/27 8" @ 2420  
CO
- 5/4 **Bart 2689'**  
**Miss 2693'**  
5" @ 2679'  
TD 2694'
- 5/11 TD 2694'  
**Bart 2689'**  
**Miss 2693'**  
5" @ 2679'  
15 qts  
Pump 20 oil Pot  
39° Gr.  
Comp

**COMPLETED**

Map No. \_\_\_\_\_ Sec. 3 Twp. 28 R. 5E

Well No. 3 Clark

Rex & Morris etal. Company

FIRST REPORT Contractor

SW NE SE

SECTION PLAT

990 Ft. from N. Line

\_\_\_\_\_ Ft. from S. Line

830 Ft. from E. Line

\_\_\_\_\_ Ft. from W. Line

			6

Butler County

Location X

Rig up \_\_\_\_\_

Drilling and Remarks:

RECORD

Cased \_\_\_\_\_ in., \_\_\_\_\_ ft.

Sand \_\_\_\_\_

Gas \_\_\_\_\_

Oil \_\_\_\_\_

Total Depth \_\_\_\_\_

PRODUCTION

1st 24 hrs. Nat. \_\_\_\_\_

1st 24 hrs. after shot \_\_\_\_\_

Gas \_\_\_\_\_ Cu. Ft.

Dry Hole \_\_\_\_\_

Abandoned \_\_\_\_\_

Date

MAR 16 1949 19

S. J. LEWIS Scout

Map No. K 11 Sec. 3 Twp. 28 R. 5E

Well No. 3 Clark

Rex & Morris etal. Company

COMPLETE Contractor

SW NE SE

*E 1/26*

SECTION PLAT

990 Ft. from N. Line

\_\_\_\_\_ Ft. from S. Line

830 Ft. from E. Line

\_\_\_\_\_ Ft. from W. Line

			6

Butler County

RECORD

Location \_\_\_\_\_

Cased \_\_\_\_\_ in., \_\_\_\_\_ ft.

Rig up \_\_\_\_\_

Sand \_\_\_\_\_

Drilling and Remarks:

Gas \_\_\_\_\_

Oil \_\_\_\_\_

Total Depth 2694

*Bar 2659*  
*Mis 2693*  
*5" @ 2679*  
*109 to*  
*Prog soil*  
*39 = 1/2*

PRODUCTION

1st 24 hrs. Nat. \_\_\_\_\_

1st 24 hrs. after shot \_\_\_\_\_

Gas \_\_\_\_\_ Cu. Ft.

Dry Hole \_\_\_\_\_

Abandoned \_\_\_\_\_

Date

MAY 11 1949

19

S. J. LEWIS

Scout