


KANSAS

Section 26 Township 13 Range 24W

Well No. #1 Bauer

Company Anschutz Drlg.

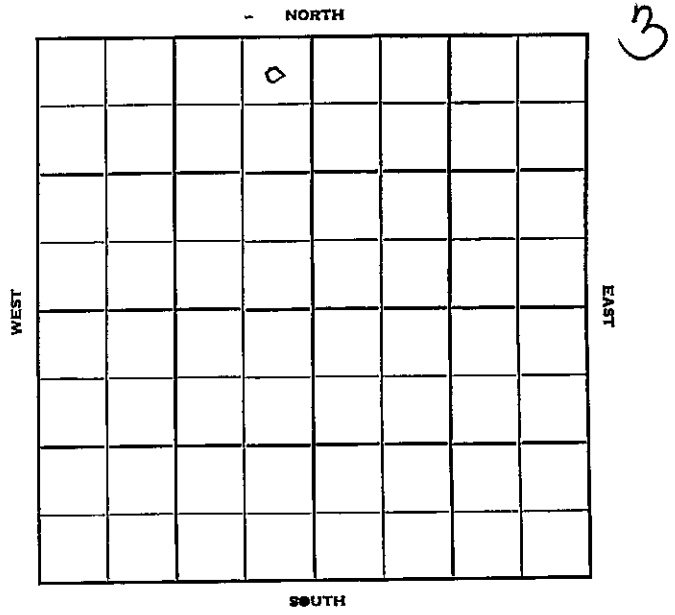

Trego

KANSAS

Sec. 26 Twp. 13 R. 24W

Well No. #1 Bauer Farm

Anschutz Drlg. _____ Company

Anschutz Drlg. Contractor

200 Wildcat

Ft. from N. Line


Ft. from S. Line

330

Ft. from E. Line

Ft. from W. Line

NE NE NW

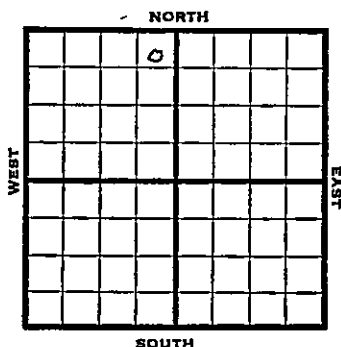

1951 | Elev. 2427' | REPORT

11/21 | RUR

12/19 Spud 11-21-51

D&A , TD 3650

8" @ 229

Top. 3509 h

Heeb. 3726

Tor. 3741

Lans. 3756

В КС 4010

Miss. L301

Viola 4490

Simp. 4614

Arb. 4621

DD 4650

D&A

ABANDONED

County Trego State Kansas
 Sec. 26 (Blk. Twp.) 13 (Sur. Rge.) 24W Map No. _____
 Operator Anschutz D 1g.
 Well No. 1 Farm Bauer

Elev. _____ Location NE NE NW

0

FIRST RECORD

330 Ft. From N Line NW

330 Ft. From E Line Quarter

Ist. Report NOV 21 1951

Completion _____


Remarks _____

Anschutz Drlg. - Contr.

Spudding Date _____

Drig. Data Wildcat

RUR

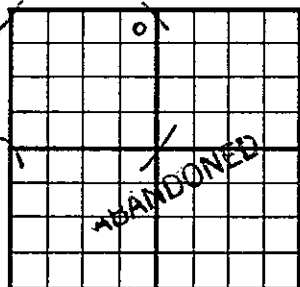County Trego State KansasSec. 26 (Blk. Twp.) 13 (Sur. Rge.) 24W Map No.Operator Anschutz Drlg.Well No. 1 Farm BauerElev. 2427 Location NE NE NW330 Ft. From N Line NW330 Ft. From E Line Quarter

1st. Report

Completion DEC 1 9 1951Remarks WildcatAnschutz - Contr.Spudding Date 11-21-51Drlg. Data D & A TD 46508" @ 229 Top. 3509 Heeb. 3726Tor. 3741 Lans. 3756 B KC 4010Miss. 4301 Viola 4490 Simp. 4614Arb. 4621 TD 4650D & A

J. E. TYRA