

DX 78-1


Cowley

KANSAS

Section 6 Township 30 Range 6 E

Well No. #1 Shawver - Atlanta Ranch

Company Stelbar Oil

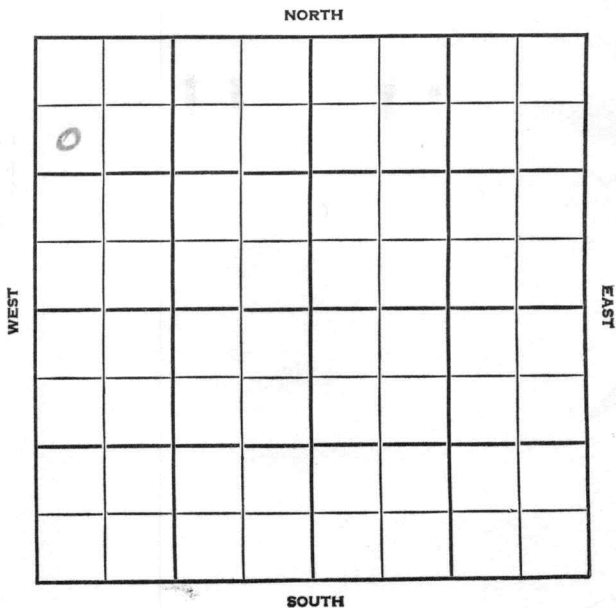

Cowley

KANSAS

SEC. 6	TWP. 30	R. 6E
-----------	------------	----------

WELL NO. #1 Shawver - *Atlanta Ranch* FARM

COMPANY Stelbar Oil

CONTRACTOR Co. Tools

Couch


_____ Ft. from N. Line

_____ Ft. from S. Line

_____ Ft. from E. Line

_____ Ft. from W. Line

SW NW NW

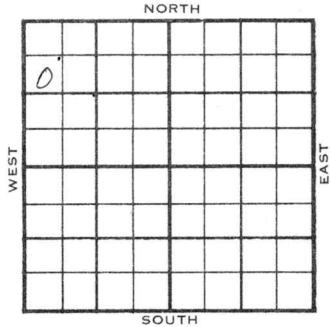

1956	ELEVATION 1346	REPORT
------	-------------------	--------

2-22

Comm. 2-20-56

8" @ 120/80

WORT

4-4

5 1/2" @ 2797 w/80

CO to 2817

FU 800' fluid, 50% oil 12 hrs.

F/ 60 bo,

Comp. 25 bopd

KC 2153

Btv1 2765-2815

TD 2817

COMPLETED

County Cowley Elev. _____
 Sec. 6 Twp. 30 Rge. 6E
 Company Stelbar Oil
 Farm Name Shawver No. 1

TOPS	DEPTH	LOG	DATUM	Loc. in Sec.
Anh.				SW NW NW
TP.				
H.				
Tr.				
Dg.				
Bl.				
L.				Geol. _____
K.C.				Contr. _____
B.K.C.				
Ce.				Co. tools
C.				
M.				Pool
M.				Couch
K.				
Mz.				
Mq.				
V.				
S.				
S.				
A.				
R.				
PE.				
G.				
T.D.				

0
 FEB 22 56
 FIRST REPORT

Date Comm. 2-20-56
8" @ 120/80 WORT

Co.
 Lse.
 No.
 Sec.
 T.
 R.

CORRECTION

FORM 513 REV. SUNRAY

County Cowley Elev. _____ Co.
Sec. 6 Twp. 30 Rge. 6E
Company Stelbar
Farm Name Shawver-Atlanta Ranch No. 1

TOPS	DEPTH	LOG	DATUM	Loc. in Sec.
Anh.				SW NW NW
TP.				
H.				
Tr.				
Dg.				
Bl.				
L.				
K.C.				Geol. _____
B.K.C.				Contr. _____
Ce.				
C.				
M.				
M.				Pool _____
K.				
Mz.				
Me.				
V.				
S.				
S.				
A.				
R.				
PE.				
G.				
T.D.				

0

CORRECTION

APP 4 1966

Date Comm. Reported #1 Shawver No. _____
Sec. _____
T. _____
R. _____

County Cowley Elev. 1346
 Sec. 6 Twp. 30 Rge. 6E
 Company Stelbar Oil
 Farm Name Shawver-Atlanta Ranch No. 1

TOPS	DEPTH	LOG	DATUM	Loc. in Sec.
Anh.				SW NW NW
TP.				
H.				
Tr.				
Dg.				
Bl.				
L.				
K.C.	<u>215.3</u>			Geol.
B.K.C.				Contr.
Ce.				Co. tools
C. <u>B+1</u>	<u>2765-2815</u>		<u>1419</u>	Pool
M.				Couch
M.				
K.				
Mz.				
Mq.				
V.				
S.				
S.				
A.				
R.				
PE.				
G.				
T.D.	<u>2817</u>			

COMPLETE
 APR 4 '56

Date Comm. 2-20-56
8" @ 120/80 5 $\frac{1}{2}$ " @ 2797/80 CO to 2817
FU 800' fluid 50% oil 12 hr.
F/ 60 bo Comp. 25 bopd

Co. No. Sec. T. R.