


Butler

Map No. Kans. Sec. 7 Twp. 28 R. 5
 Well No. 1 Layton Farm
Kismet + Sanford Company

NORTH

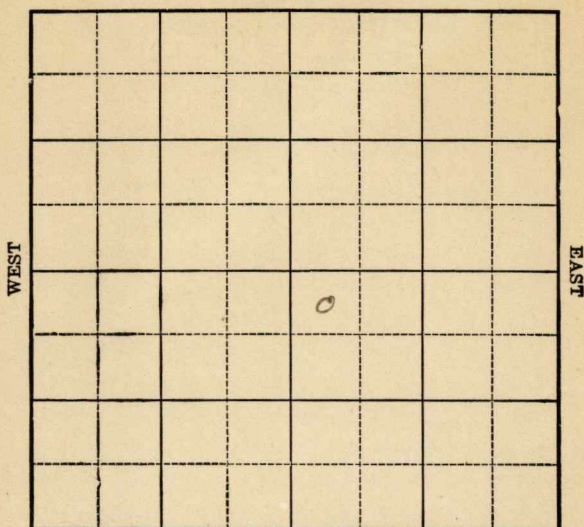

SOUTH

Location _____
 Drilling Remarks _____

Rig Up _____
 Drilling Remarks _____

RECORD

Cased _____ in. _____ ft.
 Sand _____
 Gas _____
 Oil _____
 Total Depth _____


PRODUCTION

1st 24 hrs. Nat. _____
 1st 24 hrs. after shot _____
 Gas _____ cu. ft.
 Dry Hole _____
 Abandoned _____

Map No. 1 Sec. 7 Twp. 28 R. 5Well No. 1 Layton FarmKismet & Sandford Company330 Ft. from N. Line

Ft. from S. Line

Ft. from E. Line

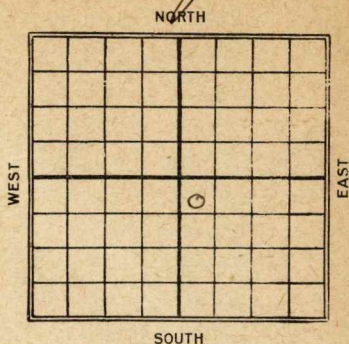330 Ft. from W. Line1926

Date	REPORT
9/15	Rig up
9/22	rigging up
9/29	Spudding
10/13	Drilg 925'
10/27	S.D. 1600'
11/11	10" - 1605'
11/17	S.D. 1605'
11/23	Same
12/8	S.D. 2200'
12/15	Same
12/22	—
12/30	—
1927	—
1/6	—
1/13	—
1/19	—
1/26	—
2/3	—
2/10	—
2/16	sdyl shale 2629-43'
	" " 2750-75'
	Top line 2794'
	(over)

water 2810 feet.
dry & aband 2812'

11 **KANSAS** *Butler*
 Map No. *1* Sec. *7* Twp. *28* R. *5*

Well No. *Hayton*
Gisnet & Sandford Company

Contractor

FIRST REPORTS**SECTION PLAT**

330 Ft. from N. Line

----- Ft. from S. Line

----- Ft. from E. Line

330 Ft. from W. Line

		0	

Location -----

Rig up ----- ✓

Drilling and Remarks:

RECORD

Cased ----- in., ----- ft.

Sand -----

Gas -----

Oil -----

Total Depth -----

PRODUCTION

1st 24 hrs. Nat. -----

1st 24 hrs. after shot -----

Gas ----- Cu. Ft.

Dry Hole -----

Abandoned -----

Date

SEP 15, 1926

CHAS. L. SHERWOOD

192

Scout

11 **KANSAS** Sec. 7 Twp. 28 R. 5

Well No. 1 *Hayton*
Sisner & Sanford Company

Contractor

COMPLETED

SECTION PLAT

330 Ft. from N. Line

Ft. from S. Line

Ft. from E. Line

330 Ft. from W. Line

		0	

ABANDONED

Location

Rig up

Drilling and Remarks:

Hy Shob 2629-43
 " " 2750-75

TL 2794

water 2810

DRH 2812

RECORD

Cased in., ft.

Sand

Gas

Oil

Total Depth 2812

PRODUCTION

1st 24 hrs. Nat.

1st 24 hrs. after shot

Gas Cu. Ft.

Dry Hole ✓

Abandoned ✓

Date

FEB 16 1927

CHAS. L. SHERWOOD

192

Scout