

KANSAS


Form 51-5M-4-36-Palace

Butler

Section 8 Township 28 Range 5E

Well Number #1 Church.

Company ~~Ed~~ Solomon Sid Neff

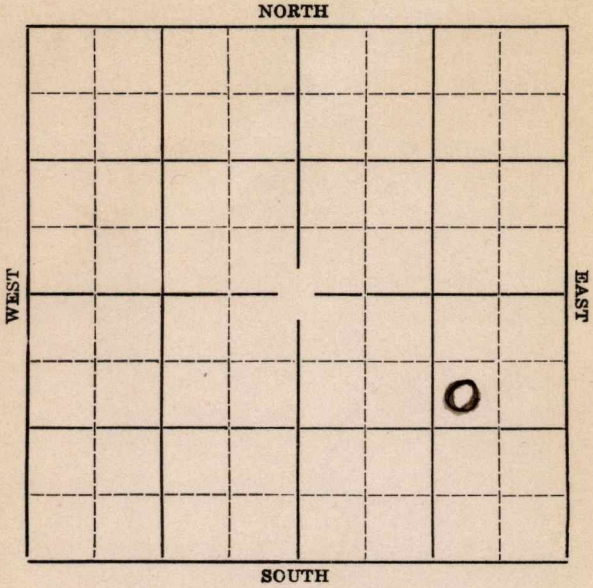

O. W. D. D


Butler

Map No. KANSAS Sec. 8 Twp. 28 R. 5E

Well No. #1 Church Farm

~~Ed Solomon~~ Sid Neff Company

NORTH

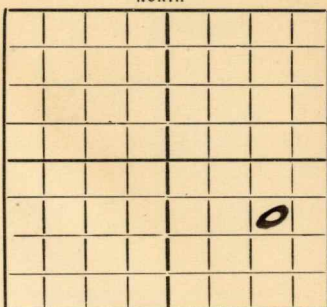

990' Ft. from N. Line

_____ Ft. from S. Line

990' Ft. from E. Line

_____ Ft. from W. Line

SOUTH

Date 1936

REPORT

O. W. D. D

6/3 Rigging up machine.

6/11 Spud.

6/18--6/25--

7/2 Shut down.

7/9 Spud.

7/16 Shut down.

7/23 -- 7/30-- 8/6-- 8/13--

8/20 12 $\frac{1}{2}$ " @ 40'. Drlg. 100'.

8/27 No report.

9/3--9/10--9/18--

9/24 Shut down. T.D. 100'.

10/1--

10/8 Drlg. 200'.

10/15--No report.

10/22--Shut down.

10/29--11/6--11/12-- 11/19--

11/25 T. D. 200'. D & A

ABANDONED

OVER OVER

1937

O. W. D. D

4/28

Old T.D. 200'.

T.D. 1875'.

D & A

FIRST REPORT

and

ABANDONED

KANSAS

Map No. 11 Sec. 8 Twp. 28 R. 5E

Well No. 1 Church

Ed Solomon Company

Contractor

SECTION PLAT

990 Ft. from N. Line

_____ Ft. from S. Line

990 Ft. from E. Line

_____ Ft. from W. Line

			0

FIRST REPORT

Location _____

Rig up _____

Drilling and Remarks:

Rigging up Machine
SJL

RECORD

Cased _____ in., _____ ft.

Sand _____

Gas _____

Oil _____

Total Depth _____

PRODUCTION

1st 24 hrs. Nat. _____

1st 24 hrs. after shot _____

Gas _____ Cu. Ft.

Dry Hole _____

Abandoned _____

Date

JUN 3 1936

19

S. J. LEWIS

Scout

Map No. 11 Sec. 8 Twp. 28 R. 5E

Well No. 1 Church

Ed Solomon Company

Contractor

SECTION PLAT

990 Ft. from N. Line

_____ Ft. from S. Line

990 Ft. from E. Line

_____ Ft. from W. Line

ABANDONED

Location _____

Rig up _____

Drilling and Remarks:

DVA

RECORD

Cased _____ in., _____ ft.

Sand _____

Gas _____

Oil _____

Total Depth 200

PRODUCTION

1st 24 hrs. Nat. _____

1st 24 hrs. after shot _____

Gas _____ Cu. Ft.

Dry Hole _____

Abandoned _____

Date

NOV 25 1936 19

S. J. LEWIS

Scout

Butler **KANSAS**

Map No. 11 Sec. 8 Twp. 28 R. 5^E

Well No. 1-Church

Sid Neff Company

Contractor

FIRST REPORT

SECTION PLAT

COMPLETED
ABANDONED

990 Ft. from N. Line

_____ Ft. from S. Line

900 Ft. from E. Line

_____ Ft. from W. Line

correct CO NAME

OWDD

			0

Location _____

Rig up _____

Drilling and Remarks:

OTD 200

T.D. 1875

D+A

RECORD

Cased _____ in., _____ ft.

Sand _____

Gas _____

Oil _____

Total Depth _____

PRODUCTION

1st 24 hrs. Nat. _____

1st 24 hrs. after shot _____

Gas _____ Cu. Ft.

Dry Hole _____

Abandoned 1875

Date

APR 28 1937

19

H. D. Hatfield Scout