


Section 16 Township 13 Range 28W

Well No. #1 Mendenhall

Company Prime Drlg. Co.

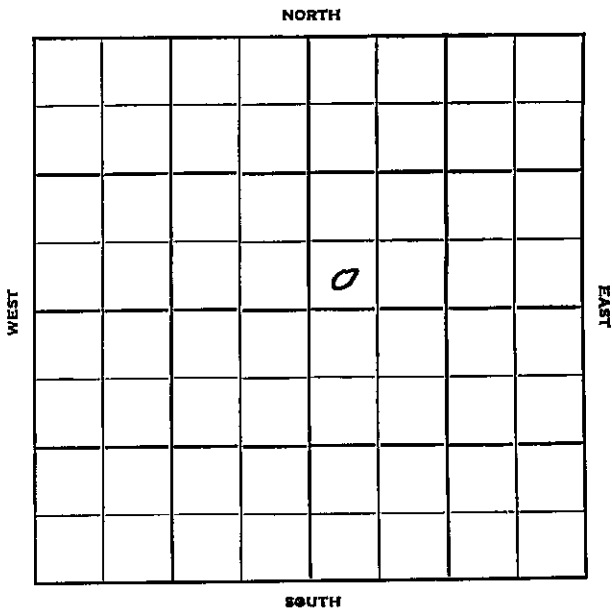

Gove

KANSAS

Sec. 16

Twp. 13

R. 28W

Well No. #1 Mendenhall Farm

Prime Drlg. Co. Company

Wildcat Contractor


Ft. from N. Line

330' Ft. from S. Line

Ft. from E. Line

330' Ft. from W. Line

SW SW NE

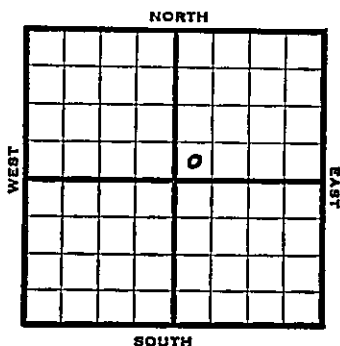

1952 Elev. 2600' REPORT

7/2 Location
 7/9 8" @ 204
 Heeb. 3759 Lans. 3799
 DST 4020-54 1 hr. 11' M 570#
 Drlg. 4140'
 7/16 Spud 6-27-52
 D & A TD 4550' 8" @ 204
 Heeb 3759' Lans. 3799'
 DST 4020-54 open. 1 hr. rec 11' mud
 570# Marm. 4006' Cong. 4381'
 Miss 4396'
 TD 4550' D & A

ABANDONED

