

SECTION 8 TOWNSHIP 28 RANGE 5 E

WELL NO. #1 Morris Neff

COMPANY Sid Neff

NORTH

						0	

WEST

EAST

SOUTH

Butler

KANSAS

SEC.	8	TWP.	28	R.	5E
------	---	------	----	----	----

WELL NO. #1 Morris Neff FARM

COMPANY Sid Neff

CONTRACTOR Bedell & Catt

Wildcat


_____ Ft. from N. Line

_____ Ft. from S. Line

_____ Ft. from E. Line

_____ Ft. from W. Line

NW SE SE

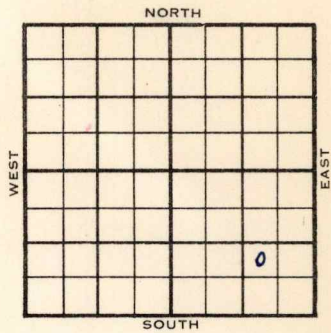

1955	ELEVATION	REPORT
------	-----------	--------

10/26 Loc

~~LXX~~
~~KLXX~~
11/2

Comm 10-25-55
8 5/8" @ 85/45

L 1760

TD 1867

D & A

ABANDONED

County Butler Elev. _____
 Sec. 8 Twp. 20 Rgs. 5E
 Company Sid Neff
 Farm Name Morris Neff No. 1

TOPS	DEPTH	LOG	DATUM
Anh.			
TP.			
H.			
Tr.			
Dg.			
BL.			
L.			
K.C.			
B.K.C.			
Ce.			
C.			
M.			
M.			
K.			
Mz.			
Mq.			
V.			
S.			
S.			
A.			
R.			
PE.			
G.			
T.D.			

Loc. in Sec. NW SE SE

Geol. _____
 Contr. Bedell & Catt

Pool Wildcat

OCT 26 1955
 FIRST REPORT

Date Comm. _____
 Location _____

Co.

Lse.

No.

Sec.

T.

R.

