


Butler

Map No. _____ Sec. 9 Twp. 28 R. 5EWell No. 1-Hoffman FarmConnell oil Company

NORTH

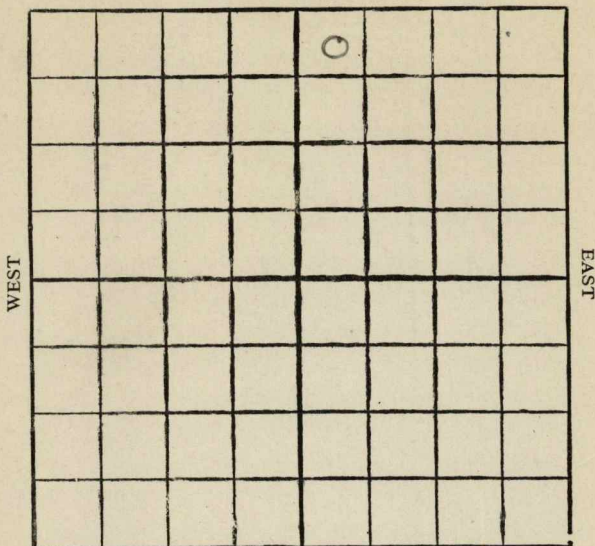

SOUTH

Location _____

Drilling Remarks _____

RECORD

Cased _____ in. _____ ft.

Sand _____

Gas _____

Oil _____

Total Depth _____

Rig Up _____

Drilling Remarks _____

PRODUCTION

1st 24 hrs. Nat. _____

1st 24 hrs. after shot _____

Gas _____ cu. ft.

Dry Hole _____

Abandoned _____


Map No. _____ Sec. 9 Twp. 28 R 5 E
 Well No. 1- Hoffman Farm
Connell oil Company

330 Ft. from N. Line

_____ Ft. from S. Line

_____ Ft. from E. Line

330 Ft. from W. Line

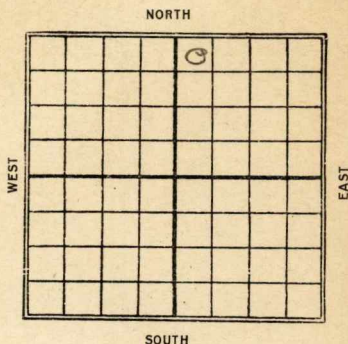

1927

Date

REPORT

4/20	Loc
4/27	timbers
5/5	Rig
5/12	spudding
5/18	Drilg 730
5/25	" 1400
6/1	" 1940
6/7	" 2190
6/15	" 2440
6/22	Top Chat 2718 HFW
	D. + H. 2727'

Butler

E

11 **KANSAS**
Map No. _____ Sec. 9 Twp. 28 R. 5Well No. 1 Hoffman
Connell Oil Co Company

Contractor

FIRST REPORTS**SECTION PLAT**330 Ft. from N. Line

_____ Ft. from S. Line

_____ Ft. from E. Line

330 Ft. from W. Line

		0	

Location ☒ _____

Rig up _____

Drilling and Remarks:

RECORD

Cased _____ in., _____ ft.

Sand _____

Gas _____

Oil _____

Total Depth _____

PRODUCTION

1st 24 hrs. Nat. _____

1st 24 hrs. after shot _____

Gas _____ Cu. Ft.

Dry Hole _____

Abandoned _____

Date

APR 20 1927

CHAS. L. SHERWOOD

192

Scout

Butter

11 KANSAS

Map No. _____ Sec. 9 Twp. 28 R. 5

Well No. 1

Cornell Oil Co

Company

Contractor

COMPLETED

SECTION PLAT

330 Ft. from N. Line

_____ Ft. from S. Line

_____ Ft. from E. Line

330 Ft. from W. Line

ABANDONED

		0	

Location _____

Rig up _____

Drilling and Remarks:

Top Chat 2718'

AFW

D&H 2727'

RECORD

Cased _____ in., _____ ft.

Sand _____

Gas _____

Oil _____

Total Depth 2727'

PRODUCTION

1st 24 hrs. Nat. _____

1st 24 hrs. after shot _____

Gas _____ Cu. Ft.

Dry Hole ✓

Abandoned ✓

Date

JUN 22 1927

192

CHAS. L. SHERWOOD

Scout