

Section 27 Township 13 Range 27W

Well No. #1 Peirano

Company Skiles

NORTH

							0

SOUTH

WEST

EAST

16

Sec. 27 Twp. 13 R. 27 W 1

Well No. # 1 Peirano Farm

Skiles Company

Contractor

Wildcat


Ft. from N. Line

330 Ft. from S. Line

330 Ft. from E. Line

Ft. from W. Line

SE SE SE
Carter # 3500.00
Sinclair & Sun - DHM

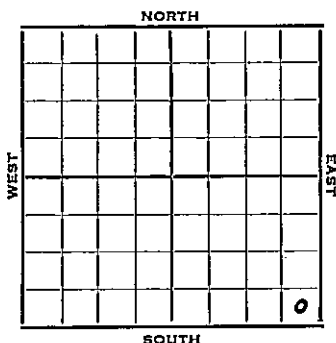

1952 Elev. - REPORT

4/2 Spud 3-30-52
10" @ 130'
Drlg. 1910'

4/9 Heeb 3752 KC 3795
DST 3840-80, $\frac{1}{2}$ hr. 1080' SW 1100#
30" FP 420# VSSO 3851-54
DSTD3903-39, 40 mins. 30' m 1050#
VSSO 3932-35 Drlg. 3965'

4/16 Spud 3-30-52
D & A TD 4487' 10" @ 130
Heeb 3752' KC 3795'
DST 3840-80 open $\frac{1}{2}$ hr, rec 1080' SW
VSSO 3851-54'
DST 3903-39 open 40 min, rec 30' mud
VSSO 3932-35
Schlumberger Tops: Heeb 3740',
Lans. 3780', B KC 4068', Cong. 4339',
Miss 4348'
DST 3953-67 open $\frac{1}{2}$ hr, rec 5' mud
TD 4487' D & A

ABANDONED

County **Gove** State **Kansas**

Sec. 27 (Blk. Twp.) 13 (Sur. Rge.) 27th Map No.

Operator Skiles

Well No. 7 Farm Peirano

Elev.	Location	SE	SE	SE
-------	----------	----	----	----

330 Ft. From S Line SE

330 Ft. From E Line Quarter

1st. Report APR 2 1952

Completion

Remarks Carter- \$ 3500.

Sinclair & Sun - DEM

Spudding Date **3-30-52**

Drig. Data Wildcat

10ⁿ @ 130 Drlg. 1910


J. G. McGEHEE

County Gove State Kansas
 Sec. 27 (Blk. Twp.) 513 (Sur. Rge.) 27W Map No.

Operator Skiles

Well No. 1 Farm Peirano

Elev. Location SE SE SE

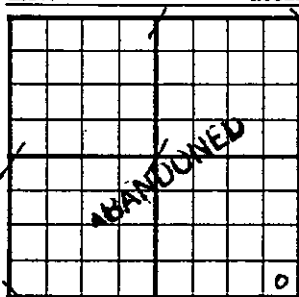

330 Ft. From S Line SE

330 Ft. From E Line Quarter

1st. Report

Completion APR 16 1952

Remarks Wildcat

Spudding Date 3-30-52

Drilg. Data D & A TD 4487

10" @ 130 Heeb. 3752 KC 3795

DST 3840-80 open $\frac{1}{2}$ hr. Rec. 1080' sw

VSSO 3851-54 DST 3903-39 open 40 min.

Rec. 30' mud VSSO 3932-35

SCHLUMBERGER TOPS

Heeb. 3740 Lans. 3780 B KC 4068

Cong. 4339 Miss. 4348 DST 3953-67

open $\frac{1}{2}$ hr. Rec. 5' mud TD 4487

D & A

J. G. McGEHEE