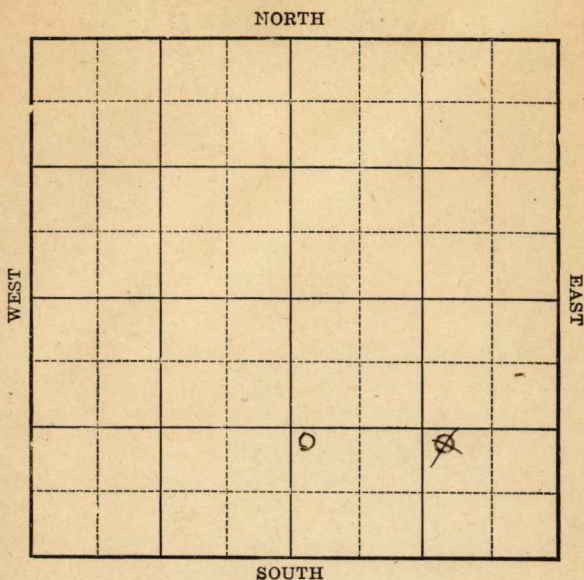


Kansas

Map No. \_\_\_\_\_ Sec. 8 Twp. 28 R. 5Well No. 1 Freeman FarmWeidline Company

FIRST REPORT

Location \_\_\_\_\_

Rig Up \_\_\_\_\_

Drilling Remarks:

Drilling Remarks:

## RECORD

Cased \_\_\_\_\_ in. \_\_\_\_\_ ft.

Sand \_\_\_\_\_

Gas \_\_\_\_\_

Oil \_\_\_\_\_

Total Depth \_\_\_\_\_

## PRODUCTION

1st 24 hrs. Nat. \_\_\_\_\_

1st 24 hrs. after shot \_\_\_\_\_

Gas \_\_\_\_\_ cu. ft.

Dry Hole \_\_\_\_\_

Abandoned \_\_\_\_\_



Map No. **KANSAS** 11 Sec. 8 Twp. 28 R. 5

Well No. 1 Freeman

Weedline Company

Contractor

## FIRST REPORT

## SECTION PLAT

|  |  |  |  |
|--|--|--|--|
|  |  |  |  |
|  |  |  |  |
|  |  |  |  |
|  |  |  |  |

Ft. from N. Line

1120 Ft. from S. Line

1120 Ft. from E. Line

Ft. from W. Line

Location

Rig up

Drilling and Remarks:

500'

## RECORD

Cased in, ft.

Sand

Gas

Oil

Total Depth

## PRODUCTION

1st 24 hrs. Nat.

1st 24 hrs. after shot

Gas Cu. Ft.

Dry Hole

Abandoned

Date

OCT 26 1922

M. A. BENEAR

191

Scout

Map No. **KANSAS** Sec. 8 Twp. 28 R. 5

Well No. 1 Freeman  
Weidman et al Company

Contractor

**ABANDONED**

**SECTION PLAT**

----- Ft. from N. Line

1120 Ft. from S. Line

----- Ft. from E. Line

200 Ft. from W. Line

|  |  |  |  |
|--|--|--|--|
|  |  |  |  |
|  |  |  |  |
|  |  |  |  |
|  |  |  |  |

*Correct Location*

Location -----

Rig up -----

Drilling and Remarks:

**RECORD**

Cased ----- in., ----- ft.

Sand -----

Gas -----

Oil -----

Total Depth -----

**PRODUCTION**

1st 24 hrs. Nat. -----

1st 24 hrs. after shot -----

Gas ----- Cu. Ft.

Dry Hole -----

Abandoned 2911

Date

JAN 6 1923

M. A. BENEAR

191

Scout