


Section 13 Township 13 Range 28-W

Well No. #1 T. L. Smith Estate

Company Texon etal

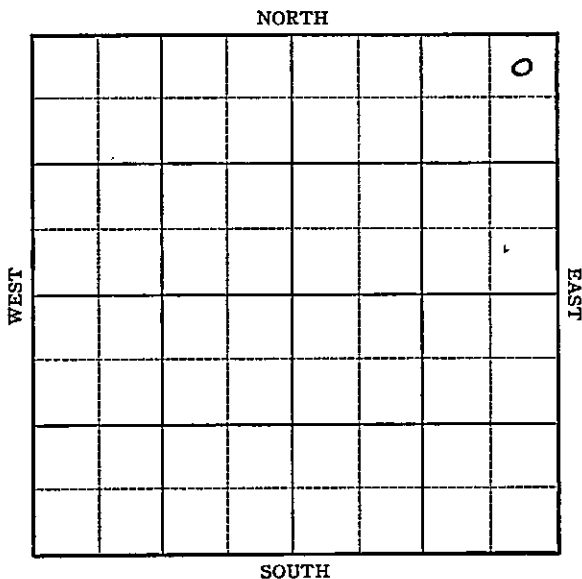


Sec. 13 Twp. 13 R. 28

Well No. #1 T. L. Smith Estate Farm

Texon etal Company

NORTH

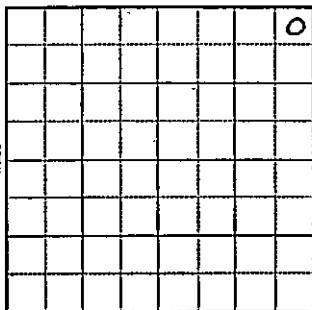

330 Ft. from N. Line

\_\_\_\_\_ Ft. from S. Line

330 Ft. from E. Line

\_\_\_\_\_ Ft. from W. Line

*Elev. 2527*

SOUTH

1943

R E P O R T

- 11/10 ·Derrick
- 11/17 Drlg. 205'
- 11/24 13" @ 198  
Drlg. 1300'
- 12/1 Drlg. 2960'
- 12/8 Drlg. 3802  
Land 3765'
- 12-15 TD 3992'  
SD repairs
- 12/22 Drlg. 4073
- 12/29 Miss 4300  
Drlg. 4332'

1944

- 1/5 Arb 4539  
No shows  
TD 4645'

**ABANDONED**

**KANSAS**  
 Map No. N-M Sec. 13 Twp. 13 R. 28W

Well No. I T. L. Smith Estate

Texon etal. Company

FIRST REPORT Contractor

**NE/C**

330 Ft. from N. Line

\_\_\_\_\_ Ft. from S. Line

330 Ft. from E. Line

\_\_\_\_\_ Ft. from W. Line

**SECTION PLAT**

			2

**Wildcat**

Location \_\_\_\_\_

Rig up \_\_\_\_\_

Drilling and Remarks:

**Derrick**

**RECORD**

Cased \_\_\_\_\_ in., \_\_\_\_\_ ft.

Sand \_\_\_\_\_

Gas \_\_\_\_\_

Oil \_\_\_\_\_

Total Depth \_\_\_\_\_

**PRODUCTION**

1st 24 hrs. Nat. \_\_\_\_\_

1st 24 hrs. after shot \_\_\_\_\_

Gas \_\_\_\_\_ Cu. Ft.

Dry Hole \_\_\_\_\_

Abandoned \_\_\_\_\_

Date

NOV 10 1943 19

S. J. LEWIS Scout

KANSAS

Map No. NM Sec. 13 Twp. 13 R. 28WWell No. I T. T. Smith EstateTexon etal. CompanyABANDONED Contractor

NE/C

## SECTION PLAT

330 Ft. from N. Line

Ft. from S. Line

330 Ft. from E. Line

Ft. from W. Line

			2

Wildcat

Location \_\_\_\_\_

Rig up \_\_\_\_\_

Drilling and Remarks:

Oil & 4539No shows

## RECORD

Cased \_\_\_\_\_ in., \_\_\_\_\_ ft.

Sand \_\_\_\_\_

Gas \_\_\_\_\_

Oil \_\_\_\_\_

Total Depth 4645

## PRODUCTION

1st 24 hrs. Nat. \_\_\_\_\_

1st 24 hrs. after shot \_\_\_\_\_

Gas \_\_\_\_\_ Cu. Ft.

Dry Hole \_\_\_\_\_

Abandoned \_\_\_\_\_

Date .

JAN 5 1944 19S. J. LEWIS Scout