


Section 13 Township 13 Range 29W

Well No. #1 Priefert

Company Wycoff Drlg.

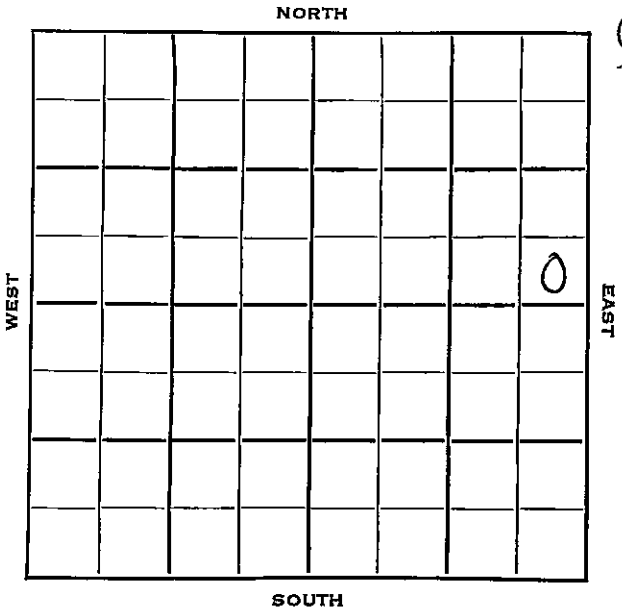

8

WEST

EAST

Gove KANSAS


SEC.	TWP.	R.
13	13	29 W

WELL NO. # 1 Priefert FARM

COMPANY Wycoff Drlg.

CONTRACTOR Wycoff Wildcat

_____ Ft. from N. Line
 330 _____ Ft. from S. Line
 330 _____ Ft. from E. Line
 _____ Ft. from W. Line

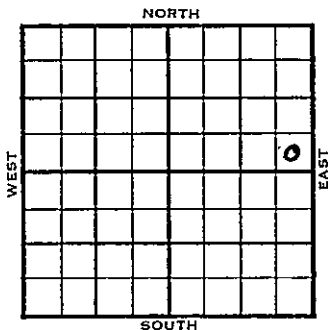

SE SE NE
 Carter - Ac & DHM

	ELEVATION	REPORT
1953	2761'	

10/7 RUR
 10/14 Anhy 2254'
 Drlg. 265'
 10/21 Top 3599½ Heeb 3894, Tor 3911, Lans 3931
 DST 4151-79, ¾ hrs., 17' socm, 900#
 B KC 4223, Marm 4252
 DST 4301-39, 1 hr., 12' M
 Drlg. 4339'
 10/28 Spud 10-7-53
 D&A
 TD 4613'
 Anhy 2254', Top 3599, Heeb 3894, Tor 3911', Lans 3931'
 DST 4151-79, opn ¾ hrs., rec. 17' socm, 900#
 B KC 4223', Marm. 4252'
 DST 4301-39, opn 1 hr., rec. 12' mud, Off
 Cong 4504', Miss 4513'
 TD 4613'
 D&A

ABANDONED

County Gove State KansasSec. 13 (Blk. Twp.) 13 (Sur. Rge.) 29W Map No.Operator Wycoff Drlg.Well No. I Farm FriefertElev. Location SE SE NE

330 Ft. From S Line NE530 Ft. From E Line Quarter1st. Report OCT 7 1953

Completion

Remarks Carter - ac & DHMWycoff - Contr.

Spudding Date

Drlg. Data WildcatR U R

