


KANSAS

FORM 51 5M BR1X

Section 9 Township 28 Range 5E

Well No. #1 Smith

Company Skelly

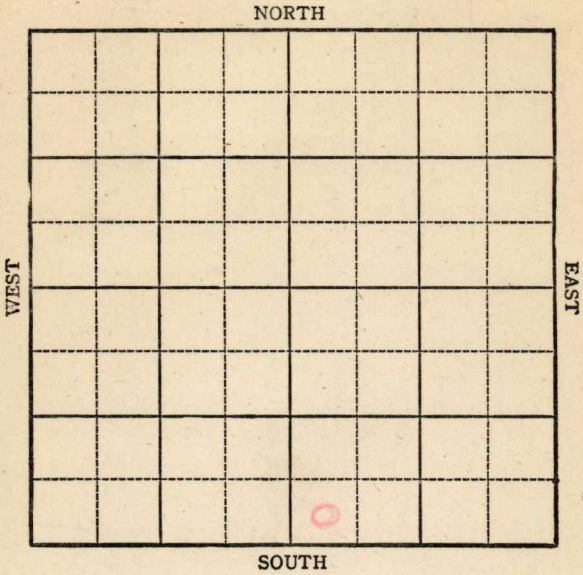

Sec. 9 Twp. 28S R. 5E

Well No. #1 Smith Farm

Skelly Company


Miscellaneous

_____ Ft. from N. Line

330 Ft. from S. Line

_____ Ft. from E. Line

330 Ft. from W. Line

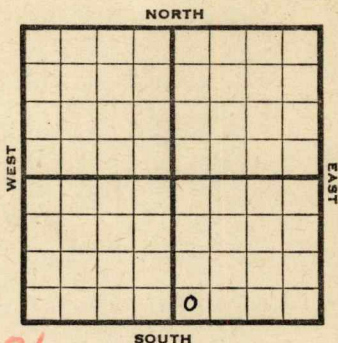

SW SE

Elev. 1306

1945

R E P O R T

- 1-10 Location
- 1/17 "
- 1/26 "
- 1/31 Cable rig
- 2/7 " "
- 2/14 " "
- 2/21 Spud 65'
- 2/28 Drlg 1215
- 3/7 12" @ 840
10" @ 1660 Fsg
- 3/14 10" @ 1695
Drlg 1880
- 3/23 8" @ 2040
KC 2182
Drlg. 2390'
- 3/29 6" @ 2460
Miss 2722
TD 2805 UR 6"
- 4/5 6" @ 2796
Drlg. 2915
- 4/11 **Misener 3206**
Simp sd 3225
Arb 3235
TD 3244' HFW

ABANDONED

Pool Name Miscellaneous

Map No. 11 Sec. 9 Twp 28 R. 5E

Well No. 1 Smith

Skelly

Company

FIRST REPORT

Contractor

SW SE

SECTION PLAT

_____ Ft. from N. Line

330 Ft. from S. Line

_____ Ft. from E. Line

330 Ft. from W. Line

Butler

Location X

Rig up _____

Drilling and Remarks:

RECORD

Cased _____ in., _____ ft.

Sand _____

Gas _____

Oil _____

Total Depth _____

PRODUCTION

1st 24 hrs. Nat. _____

1st 24 hrs. after shot _____

Gas _____ Cu. Ft.

Dry Hole _____

Abandoned _____

Date

JAN 1 0 1945 19

S. J. LEWIS

Scout

Kansas

Pool Name Miscellaneous

Map No. 11 Sec. 9 Twp. 28 R. 5E

Well No. 1 Smith

Skelly Company

ABANDONED Contractor

SW SE

SECTION PLAT

 Ft. from N. Line

330 Ft. from S. Line

 Ft. from E. Line

330 Ft. from W. Line

Butler Elev. 1306

Location

Rig up

Drilling and Remarks:

Murine 3206
Smy Sol 3225
Cor 3235
XFN

RECORD

Cased in. ft.

Sand

Gas

Oil

Total Depth 3244

PRODUCTION

1st 24 hrs. Nat.

1st 24 hrs. after shot

Gas Cu. Ft.

Dry Hole

Abandoned

Date

APR 11 1945 19

S. J. LEWIS Scout