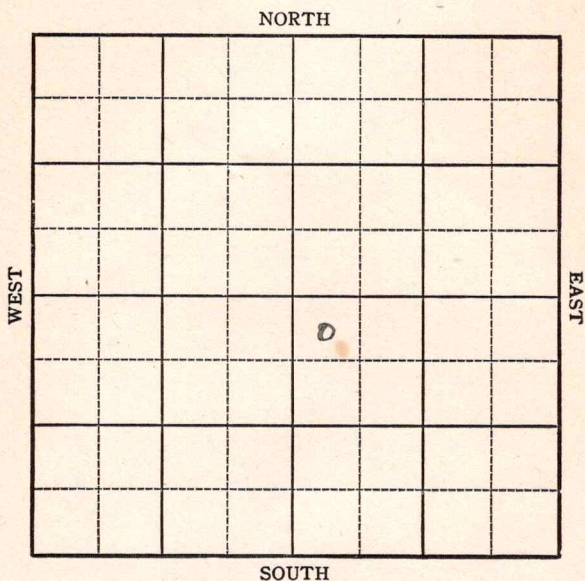


Section 5 Township 14 Range 18WWell No. #1 ParkCompany Darby, Cont'l & Cities Service

KANSAS

Sec. 5 Twp. 14 R. 18-W

Well No. #1 Park Farm

Darby, Cont'l & Cities Service Company


NW SE

330 Ft. from N. Line

Ft. from S. Line

Ft. from E. Line

330 Ft. from W. Line

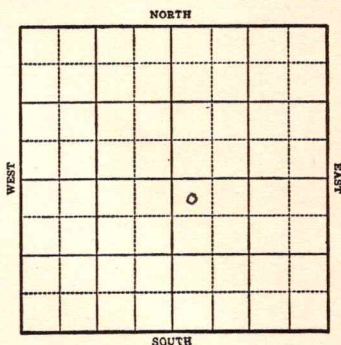

1944

R E P O R T

1-26 Derrick

2/2 Rotary

2/8 Anhy 1260
8" @ 1265

2/15 Drlg. 1347
Wreford 2335
Drlg. 2935'

2/23 Topeka 3065
Lans 3334
BKC 3561
Cong 3625
Arb 3711
TD 3745

ABANDONED

KANSAS
Map No. 7 Sec. 5 Twp. 14 R. 18W

Well No. 1 ParkDarby, Cont'l & Cities Service
Company

FIRST REPORT

Contractor

NW SE

SECTION PLAT

330

Ft. from N. Line

Ft. from S. Line

Ft. from E. Line

330

Ft. from W. Line

		0	

Wild cat

Location _____

Rig up _____

Drilling and Remarks:

Derrick

RECORD

Cased _____ in., _____ ft.

Sand _____

Gas _____

Oil _____

Total Depth _____

PRODUCTION

1st 24 hrs. Nat. _____

1st 24 hrs. after shot _____

Gas _____ Cu. Ft.

Dry Hole _____

Abandoned _____

Date

JAN 26 1944 19S. J. LEWIS Scout

Ellis

Map No. KANSAS Sec. 5 Twp. 14 R. 18WWell No. 1 ParkDarby, Cont'l & Cities Service Company

ABANDONED

Contractor

NW SE

SECTION PLAT

330


Ft. from N. Line

Ft. from S. Line

Ft. from E. Line

330

Ft. from W. Line

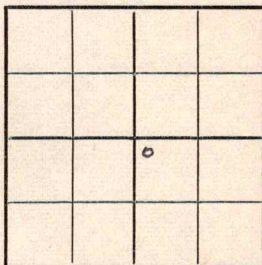

Wildcat

Location _____

Rig up _____

Drilling and Remarks:

Top: 16065
Line 3334
BAC 3561
Cong 3625
CE 43711

RECORD

Cased _____ in., _____ ft.

Sand _____

Gas _____

Oil _____

Total Depth 3745

PRODUCTION

1st 24 hrs. Nat. _____

1st 24 hrs. after shot _____

Gas _____ Cu. Ft.

Dry Hole _____

Abandoned _____

Date

FEB 23 1944 19

S. J. LEWIS Scout