

Cowley

KANSAS


SECTION 11 TOWNSHIP 30S RANGE 6E

WELL NO. #1 Blair Ranch

COMPANY H.H. Blair

NORTH

SW SW-<sup>NW</sup>SW

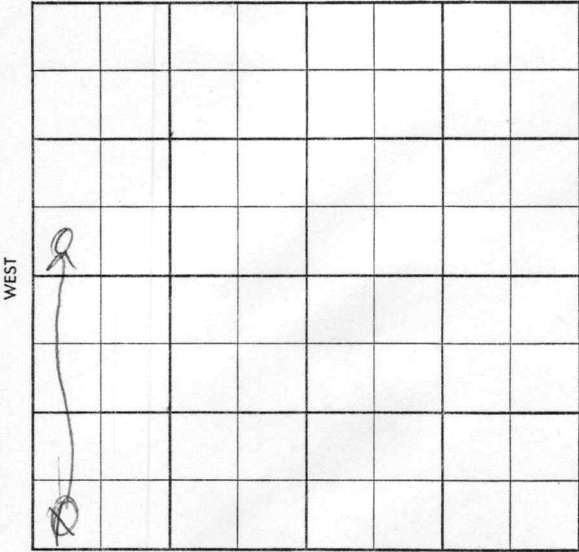

SOUTH



CORRECTION ~~Pool~~ ~~Facet~~

S-513-A

CO. Cowley ELEV. 1452  
SEC. 11 TWP. 30 RGE. 6E  
COMPANY H. H. Blair NO. 1

COMPLETE

JUN 18 '58

FARM Blair Ranch

LOC. ~~S. 34 St.~~ SE 1/4 SW 1/4

Lay 2148
KC 2156
BKC 2378
M 2852
TD 2897

GEOL. \_\_\_\_\_  
CONTR. Watson Tools  
POOL \_\_\_\_\_  
SPUD 1-6-58

Location

JAN 2 '58 JAN 8 '58 MIRA

8" 200

Ø 2732

DST 2162-77 60"

840 gip 125 140cm

BHP 275/30 DST 2872-97

60" 9/50" 1670' clean 0 60"

140cm 150' SMO BHP

945/45 - 1005/45 5 1/2 2869?

Log + app Lay 2149 KC 2156

BKC 2378 M 2852

2897 FU 1800 oil 24 hrs

Ø 10 BOPK NW 20 hrs

Ø 9 BOPK NW 20 hrs

FEB 19 '58

FEB 26 '58

MAR 5 '58

MAR 19 '58

FEB 26 '58

FEB 26 '58

APR 9 '58

APR 15 '58

APR 23 '58

APR 30 '58

MAY 7 '58

MAY 14 '58

MAY 21 '58

P 30 BOPK + trw

MAY 28 '58

JUN 3 '58

JUN 11 '58

JUN 18 '58

P 21 BOP 25 BW 24 hrs

MISS 2868-97

Ø 35°