

Ellis County


FORM 51 5M 1-42 PETROL

KANSAS

Section 13 Township 14 Range 18W

Well No. 1 Stecklein "A"

Company Bridgeport

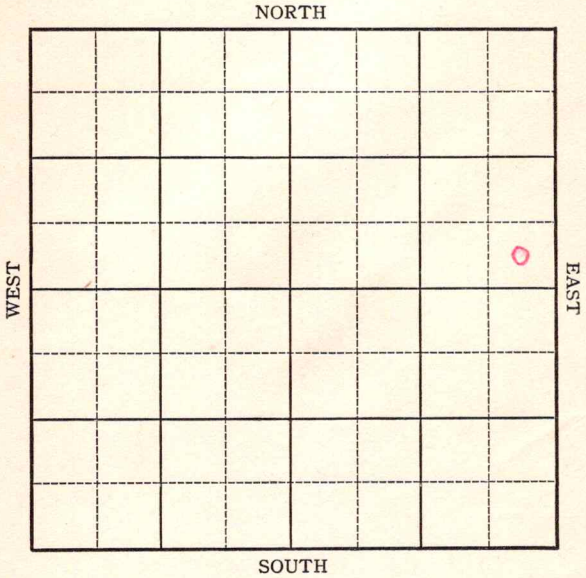

KANSAS


Ellis

Sec. 13 Twp. 14 R. 18W

Well No. #1 Stäcklein "A" Farm
Bridgeport Company

Wildcat

NORTH

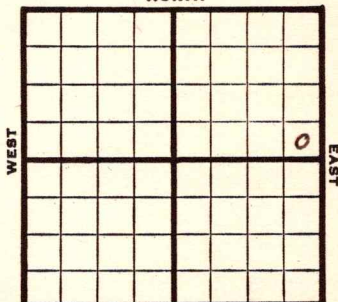

SOUTH

Elev. 1982

1944

REPORT

6/27 Location
7/12 Anhy 1175 8" @ 1176
Drlg 2705
7/19 Heetner 3250 Lans 3290
Arb 3552 TD 3577
5" @ 3567 RUST DO
7/26 Arb. 3557 Corrected
5" @ 3582. TD 3594
750' Wtr. in 12 hrs.PB.
8/2 Arb 3557
5" @ 3572
Water
TD 3594

ABANDONED

3290
1942
1208
3557
1942
1595

Pool Name Wildcat**KANSAS**Map No. 77 Sec. 13 Twp. 14 R. 18WWell No. 1 Stecklein "A"Bridgeport


Company

FIRST REPORT

Contractor

SE NE

SECTION PLAT

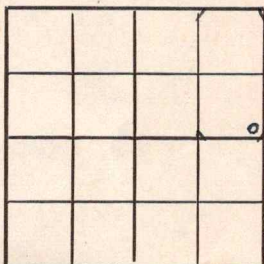 Ft. from N. Line330 Ft. from S. Line330 Ft. from E. Line Ft. from W. LineEllis CountyLocation XRig up

Drilling and Remarks:

RECORD

Cased in., ft.Sand Gas Oil Total Depth

PRODUCTION

1st 24 hrs. Nat. 1st 24 hrs. after shot Gas Cu. Ft.Dry Hole Abandoned

Date

JUN 28 1944 19S. J. LEWIS Scout

KANSAS

Pool Name WildcatMap No. 71 Sec. 13 Twp. 14 R. 18WWell No. 1 Stecklein "A"Bridgeport

Company

ABANDONED

Contractor

SE NE

SECTION PLAT

Ft. from N. Line

330

Ft. from S. Line

330

Ft. from E. Line

Ft. from W. Line

Ellis County

Location

Rig up

Drilling and Remarks:

Ar 835575'03572Noted

RECORD

Cased in., ft.Sand Gas Oil Total Depth 3594

PRODUCTION

1st 24 hrs. Nat. 1st 24 hrs. after shot Gas Cu. Ft.Dry Hole Abandoned

Date

AUG 2 1944 19S. J. LEWIS