


Section 7 Township 14 Range 18W

Well No. #1 Kansas State

Company Sunray Oil

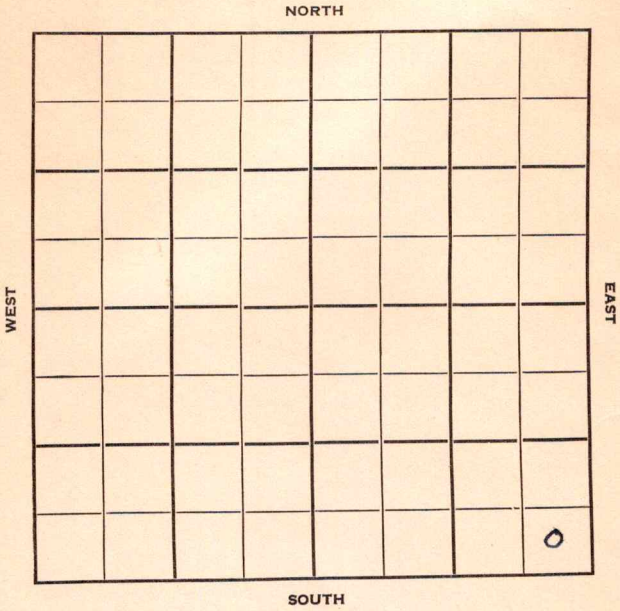

Ellis

KANSAS

Sec. 7 Twp. 14 R. 18W

Well No. #1 Kansas State Farm

Sunray Oil Company

Stickle Drlg. Contractor


Ft. from N. Line

330 Ft. from S. Line

330 Ft. from E. Line

Ft. from W. Line

SE 1/4 SE SE SE

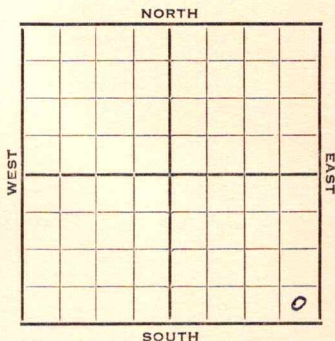

1952

Elev. 2061'

REPORT

10/29 Spud 10-24-52
8" @ 269'
Drlg. 1790'

11/5 Heeb. 3318 Tor. 3340
Lans. 3365

DST 3400-3417, 1 hr. 7' OCM 240'
gas

DST 3420-48, 1 hr. 45' SGCM
975# Drlg. 3530'

11/12 Spud 10-24-52 D & A TD 3726'
8" @ 269 Heeb 3318' Tor. 3340'
Lans. 3365'

DST 3400-3417 open 1 hr. rec 7' OCM
240' gas Off

DST 3420-48 open 1 hr. rec 45' SGCM
975#

DST 3545-54 open 1 1/2 hr. rec 155' wtr.
850# B KC 3590' Cong. 3652'

Arb. 3713'

TD 3726' O + A

ABANDONED

336
300
30
300

3713
2061
1652

349

