


Section 11 Township 13 Range 30W

Well No. #1 Losey

Company Musgrove Petroleum

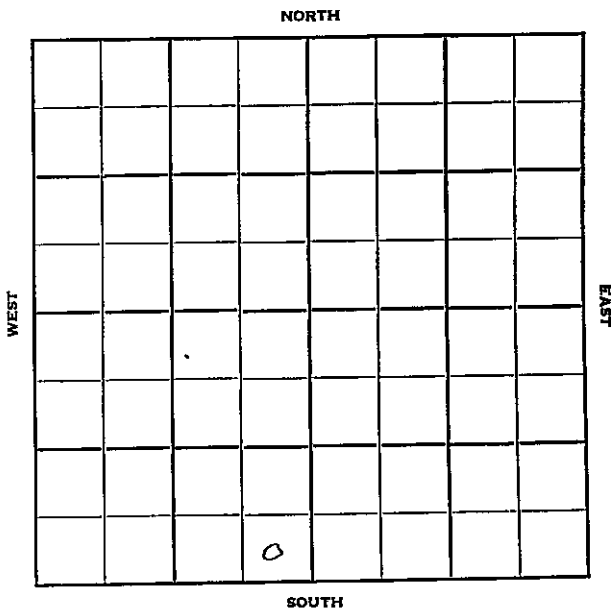

Sec. 11 Twp. 13 R. 30W

Well No. #1 Lesev Farm

Musgrove Petroleum Company

Musgrove Pet. - Contr. Contractor

Wildcat


_____ Ft. from N. Line

330' Ft. from S. Line

330' Ft. from E. Line

_____ Ft. from W. Line

SE SE SW

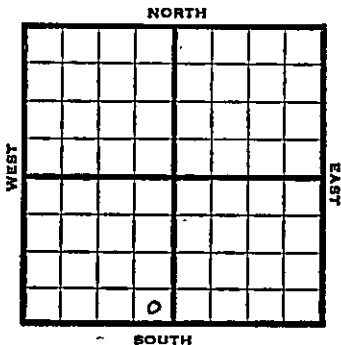

1951

Elev. 2810' REPORT

9/12 MM

10/10

Spud 9-11-51
D&A TD 4730
8" @ 210
Top 3572 Heeb. 3818
Lans. 3841
DST 4089-4109 opn 1 hr
Rec. 10' socm
Miss 4434
DST 4490-4510 opn 1 hr.
Rec. 34' mud
Viola 4662
Arb. 4695
TD 4730
D&A

ABANDONED

