

Section 8 Township 14 Range 18WWell No. #1 Kansas StateCompany Shelley & Miller

NORTH

6							

SOUTH

WEST

EAST

Ellis

KANSAS ✓

Sec. 8 Twp. 14 R. 18 W

1 Kansas State

Well No. Farm

Shelley & Miller

Company

Shelley & Miller

Contractor

Wildcat

Ft. from N. Line

330


Ft. from S. Line

Ft. from E. Line

330

Ft. from W. Line

SW SW SW

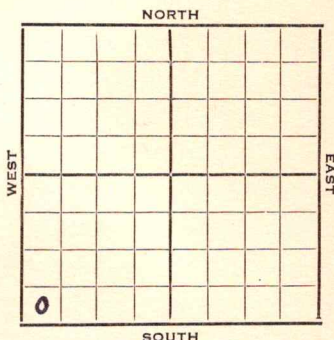

1952

Elev. 2052'

REPORT

4/9

Location

4/23

8" @ 240'

Drlg. 3225'

4/30

Heeb. 3305

Tor. 3331

Lans. 3352

Cong. 3642

Arb. 3666

DST 3667-80, 1 hr. 100' HOCM 1070#

RTD 3680

5" @ 3675' WOC

5/7

NR

5/14

DP 3680 500 A 7 BOPH for 3 hrs.

POP

5/20

NR

5/28

"

6/11

Spud 4-14-52

Oil well TD 3680' 8" @ 240'

Heeb 3305'

Tor. 3331'

Lans. 3352'

Cong. 3642'

Arb. 3666'

DST 3667-80 open 1 hr. rec 100' HOCM

TD 3680' 5" @ 3675 DP to 3680

500 A 7 BOPH 3 hr.

Comp. 114 BOPD 40% water

COMPLETED

County Ellis State Kansas

Sec. 8 (Blk.) 14 (Sur.) 18W Map No.

Operator Shelley & Miller

Well No. 1 Farm Kansas State

Elev.	Location	SW	SW	SW
-------	----------	----	----	----

330 Ft. From S Line SW

330 Ft. From W Line Quarter

1st. Report APR 9 1952

Completion

Remarks

Shelley & Miller & Contr.

Spudding Date

Drlg. Data

Wildcat

Location

J. G. McGEHEE

County	Ellis		State	Kansas		
Sec.	8	(Blk.) (Twp.)	14	(Sur.) (Rge.)	18W Map No.	
Operator	Shelley & Miller					
Well No.	1	Farm	Kansas State			
Elev.	2052	Location	SW SW SW			
COMPLETE						330 Ft. From S Line SW
						330 Ft. From W Line Quarter
						1st. Report
						Completion JUN 11 1952
						Remarks Wildcat
Shelley & Miller - Contr						
Spudding Date 4-14-52						

Drlg. Data Oil well TD 3680
 8" @ 240 Heeb. 3305 Tor. 3331
 Lans. 3352 Cong. 3642 Arb. 3666
 DST 3667-80 open 1 hr. Rec. 100' hoem
 TD 3680 5" @ 3675 DP to 3680 500 A
 7 boph 3 hr. Comp. 114 bopd 40% water

J. G. McGEHEE