


DX 78-1

Section 8 Township 14 Range 18W

Well No. 2 Kansas State

Company Shelly-Miller

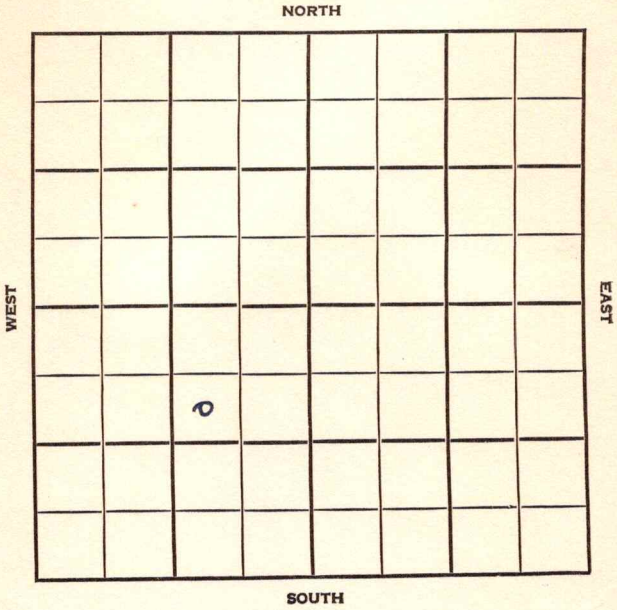

SEC. 8	TWP. 14	R. 18W ✓
-----------	------------	-------------

WELL NO. 2 Kansas State FARM

COMPANY Shelly-Miller

CONTRACTOR Shelly-Miller


Experimental Pool

990 Ft. from N. Line

Ft. from S. Line

990 Ft. from E. Line

Ft. from W. Line

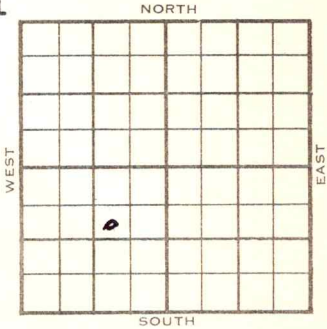

SW NE SW

	ELEVATION	REPORT
1954	2046'	

6/8 Spudding 6-7-54  
Drlg. 204

6/23 Spud 6-7-54  
D&A  
TD 3671'  
8" @ 188'  
**Lans 3355', Cong 3635'**  
DST 3632-45', opn 1/2 hrs., rec. 6'  
mud, 0#  
**Arb. 3666'**  
DST 3667-71', opn 1/2 hrs., rec. 12' mud  
140 #  
TD 3671'  
D&A

**ABANDONED**

County **Ellis** State **Kansas**

Sec. **8** (Blk.) **14** (Sur.) **18W** Map No.

Operator **Shelly-Miller**

Well No. **2** Farm **Kansas State**

Elev. Location **SW NE SW**

<b>FIRST REPORT</b>									

**990** Ft. From **N** Line **SW**

**990** Ft. From **E** Line Quarter

Ist. Report **JUN 9 1954**

Completion

Remarks

**Shelly-Miller - Contr.**

Spudding Date **6-7-54**

Drlg. Data **Experiment Pool**

**drlg. 204**

County Ellis State Kansas  
 Sec. 8 (Blk. 14) (Sur. 18W) Map No.  
 (Twp.) (Rge.)  
 Operator Shelly-Miller  
 Well No. 2 Farm Kansas State  
 Elev. 2046 Location SW NE SW


ABANDONED

0

990 Ft. From N Line SW  
 990 Ft. From E Line Quarter

1st. Report

Completion **JUN 23 1954**

Remarks Experiment Pool

Shelly-Miller - Contr.

Spudding Date 6-7-54

Drlg. Data D & A TD 3671

8" @ 188 Lans. 3355 Cong. 3635

DST 3632-45 open  $\frac{1}{2}$  hr. Rec. 6' mud

0# Arb. 3666 DST 3667-71 open  $\frac{1}{2}$  hr.

Rec. 12' mud 140# TD 3671

D & A

J. G. MCGEHEE