FORM 51 10M 8-47


KANSAS Ellis

Section 11 Township 14 Range ~~18W~~

Well No. #1 Leiker

Company Skelly

Wildcat

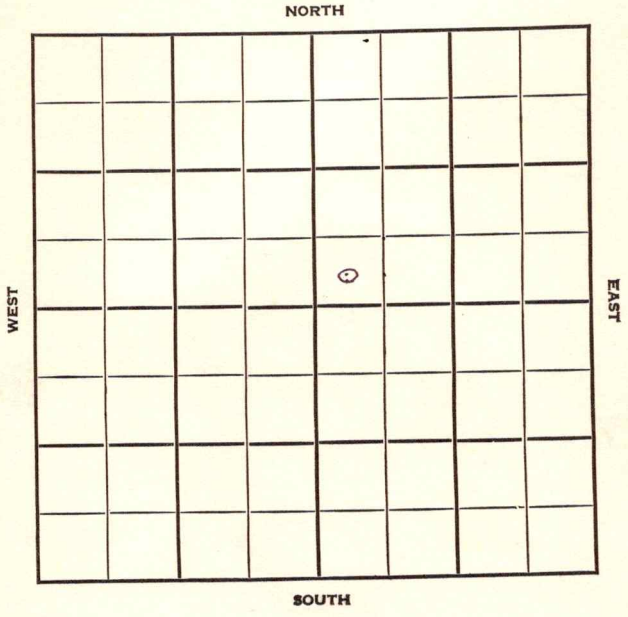

FORM 252-A
5M 12-45 PETROL


Ellis KANSAS

Sec. 11 Twp. 14 R. 18W

Well No. #1 Leiker Farm

Skelly Company

Wildcat

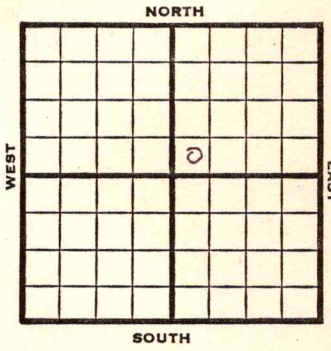

____ Ft. from N. Line

330 Ft. from S. Line

____ Ft. from E. Line

330 Ft. from W. Line

SW NE

1948 Elev. 1983' REPORT

4/14 Location

4/21 16" @ 230'
Drlg. 960'

4/28 8" @ 1186'
Drlg. 3100'

5/5 Lans. 3238'
Arb. 3580'
TD 3630'

ABANDONED

3238
1983
1255

A 3580
1983
1597

36

3580
1983
1597

Form 26—200 Bks.—1-48—Palace

Wildcat

Kansas

Map No. _____ Sec. 11 Twp. 14 R. 18W


Well No. 1 Leiker

Skelly Company

FIRST REPORT Contractor

SW NE

SECTION PLAT

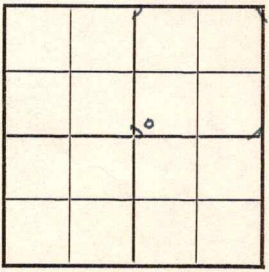

_____ Ft. from N. Line

330 Ft. from S. Line

_____ Ft. from E. Line

330 Ft. from W. Line

Ellis County

Location x

Rig up

Drilling and Remarks:

RECORD

Cased _____ in., _____ ft.

Sand

Gas

Oil

Total Depth

PRODUCTION

1st 24 hrs. Nat.

1st 24 hrs. after shot

Gas _____ Cu. Ft.

Dry Hole

Abandoned

Date

APR 14 1948 19

S. J. LEWIS Scout

Form 26—200 Bks.—1-48—Palace

Wildcat

Kansas

Map No. 71 Sec. 11 Twp. 14 R. 18W

Well No. 1 Leiker


Skelly Company

ABANDONED Contractor

SW NE

E/1983

SECTION PLAT

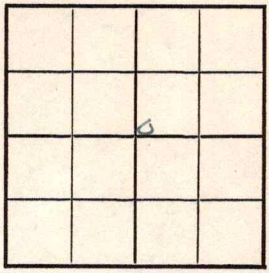

____ Ft. from N. Line

330 Ft. from S. Line

____ Ft. from E. Line

330 Ft. from W. Line

Ellis County

Location

Rig up

Drilling and Remarks:

Lease 9238

Cir #8583

RECORD

Cased ____ in., ____ ft.

Sand

Gas

Oil

Total Depth 3650

PRODUCTION

1st 24 hrs. Nat.

1st 24 hrs. after shot

Gas ____ Cu. Ft.

Dry Hole

Abandoned

Date

MAY 5 1948 19____ S. J. LEWIS Scout