KANSAS
FORM 51 5M 6-46 PETROL


Gove county

Section 15 Township 13 Range 30-W

Well No. #1, E. B. Hewitt

Company Jones and Shelborne

5

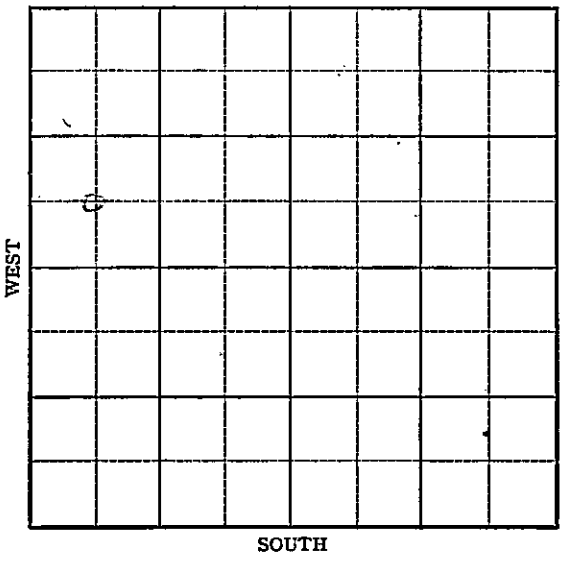

FORM 252-A
5M 6-46 PETROL

KANSAS

Gove

Sec. 15 Twp. 13 R. 30W

Well No. 1 E. B. Hewitt Farm

Jones & Shelborne Company

Wildcat


____ Ft. from N. Line

660 Ft. from S. Line

____ Ft. from E. Line

660 Ft. from W. Line

C SW NW

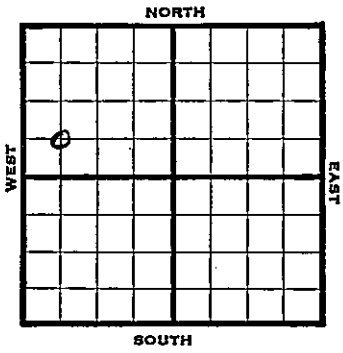

1946	REPORT Elv. 2847'
11/27	13" @ 275' Drlg 2190'
12/3	Anhy 1830' Drlg 3354'
12/10	Lans 3872' BKC 4162' Drlg 4230'
12/20	Cong 4482' Miss 4485 Viola 4701' Arb 4745 Drlg 4768'
1947	
1/4	TD, Running csg.
1/8	" "
1/15	PB 4210 5" @ 4135 Plug 4022-20 Shots 3870-75 20 shots 3875-80
1/22	Arb. 4745' T.D. 4768'

3872 4482 4485
2847 2847 2847
-1025 -1635 -1638

4701 4745
2847 2847
-1854 -1898

ABANDONED

Form 26 200 Bks. 10-46 Petrol

Wildcat

Kansas

Map No. _____ Sec. 15 Twp. 13 R. 30W


Well No. 1 E. Ba Hewitt

Jones & Shelborne Company

FIRST REPORT Contractor

C STNW

SECTION PLAT

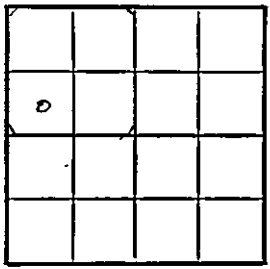

_____ Ft. from N. Line

660 Ft. from S. Line

_____ Ft. from E. Line

660 Ft. from W. Line

Gove County

Location _____

Rig up _____

Drilling and Remarks:

13" @ 275

drlg. 2190

RECORD

Cased _____ in., _____ ft.

Sand _____

Gas _____

Oil _____

Total Depth _____

PRODUCTION

1st 24 hrs. Nat. _____

1st 24 hrs. after shot _____

Gas _____ Cu. Ft.

Dry Hole _____

Abandoned _____

Date

NOV 27 1946 19

S. J. LEWIS Scout

Form 26 200 Bks. 10-46 Petrol

Wildcat

KANSAS

Map No. Sec. 15 Twp. 13 R. 30W

Well No. 1 E. B. Hewitt


Jones & Shelborne Company

ABANDONED Contractor

C SW NW

E 1,2847

SECTION PLAT

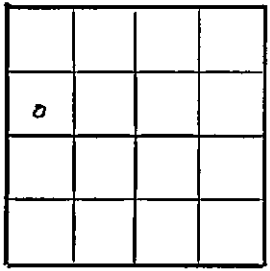

Ft. from N. Line

660 Ft. from S. Line

Ft. from E. Line

660 Ft. from W. Line

Gove County

Location

Rig up

Drilling and Remarks:

CR 4745

RECORD

Cased in., ft.

Sand

Gas

Oil

Total Depth 4768

PRODUCTION

1st 24 hrs. Nat.

1st 24 hrs. after shot

Gas Cu. Ft.

Dry Hole

Abandoned

Date

JAN 22 1947 19

S. J. LEWIS Scout