


Gove

KANCAS

SECTION 21 TOWNSHIP 13S RANGE # 30W

WELL NO. #1 Downard

COMPANY Murfin & Rains & Williamson

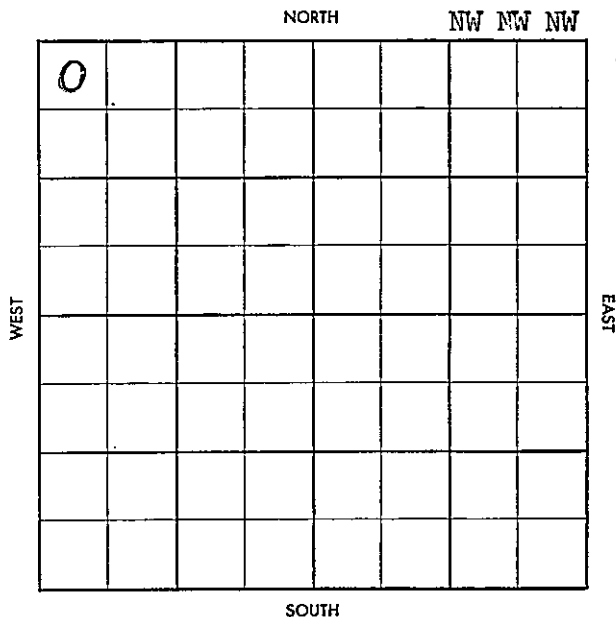

CO. Gove ELEV. 29110  
 SEC. 21 TWP. 13 RGE. 30W  
 COMPANY Murfin & NO. 1  
Rains & Williamson

JAN 15 '38  
**ABANDONED**

FARM Downard  
 LOC. NW NW NW

TP 3643
Hb 3925
TR 3950
L 3967
BKC 4312
Marm 4348
Ft scot 4508
C 4600
M 4631
TD 4735

GEOL. \_\_\_\_\_  
 CONTR. Murfin 4<sup>th</sup>  
 POOL Wilcoat  
 SPUD 12-17-57  
 DEW 2<sup>nd</sup> 57 63500  
 JAN 2 '38 64475  
8" 206/150  
 JAN 2 '38 in log  
log tops  
same as sample

CO. \_\_\_\_\_  
 LSE. \_\_\_\_\_  
 NO. \_\_\_\_\_  
 SEC. \_\_\_\_\_  
 TWP. \_\_\_\_\_  
 RGE. \_\_\_\_\_

D & A

D & A

