

KANSAS

Ellis

Section 15 Township 14 Range 18W

Well No. 1 Binder

Company Deep Rock et al

Wildcat

NORTH

0							

WEST

EAST

SOUTH

KANSAS

Ellis

Sec. 15 Twp. 14 R. 18W

Well No. #1 Binder Farm

Deep Rock Company


Wildcat

330' Ft. from N. Line

Ft. from S. Line

Ft. from E. Line

330' Ft. from W. Line

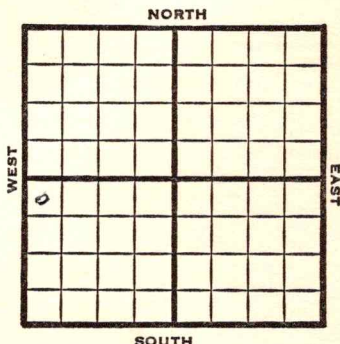

NW SW

1949

Elev 1996' REPORT

3/30

Location

4/6

8" @ 1205'

Drlg 2334'

4/13

TD 3670'

Lans. 3292'

Arb. 3640'

Aband.

ABANDONED

3292
1996
1296

3640
1996
1644

Map No. _____ Sec. 15 Twp. 14 R. 18WWell No. 1 Binder

Deep Rock etal.

Company

FIRST REPORT

Contractor


NW SW

SECTION PLAT

330 Ft. from N. Line

_____ Ft. from S. Line

_____ Ft. from E. Line

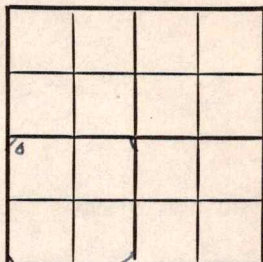330 Ft. from W. Line

Ellis County

Location X

Rig up _____

Drilling and Remarks:

RECORD

Cased _____ in., _____ ft.

Sand _____

Gas _____

Oil _____

Total Depth _____

PRODUCTION

1st 24 hrs. Nat. _____

1st 24 hrs. after shot _____

Gas _____ Cu. Ft.

Dry Hole _____

Abandoned _____

Date

MAR 30 1949 19

S. J. LEWIS

Scout

Kansas

Wildcat

Map No. 71 Sec. 15 Twp. 14 R. 18WWell No. 1 BinderDeep Rock etal.

Company

ABANDONED

Contractor

NW SW

E 41996**SECTION PLAT**

330 Ft. from N. Line Ft. from S. Line Ft. from E. Line330 Ft. from W. LineEllis CountyLocation Rig up

Drilling and Remarks:

Log 8292Per 83640**RECORD**Cased in., ft.Sand Gas Oil Total Depth 3670**PRODUCTION**1st 24 hrs. Nat. 1st 24 hrs. after shot Gas Cu. Ft.Dry Hole Abandoned

Date

APR 13 1949 19S. J. LEWIS

Scout