


Map No. KANSAS Sec. 10 Twp. 28 R. 5^E
Well No. 15 Covert Farm
W. J. Sanford Company

NORTH

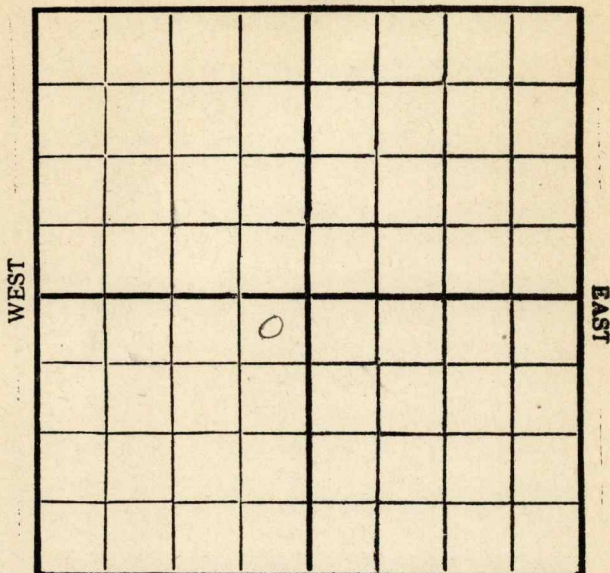

SOUTH

Location _____

Drilling Remarks _____

Rig Up _____

Drilling Remarks _____

RECORD

Cased _____ in. _____ ft.

Sand _____

Gas _____

Oil _____

Total Depth _____

PRODUCTION

1st 24 hrs. Nat. _____

1st 24 hrs. after shot _____

Gas _____ cu. ft. _____

Dry Hole _____

Abandoned _____

Map No. **KANSAS** Sec. 10 Twp. 28 R. 5^E


Well No. 1-Overk Farm
W. G. Sanford Company

330 Ft. from N. Line

_____ Ft. from S. Line

330 Ft. from E. Line

_____ Ft. from W. Line

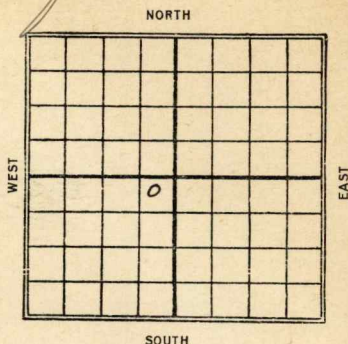

1929

Date REPORT

8/28 Location

9/4

9/11 Re G.

9/18 Spdy

9/25 Drly 350'

10/2 set 15"-1051'

10/9 Drly 1810'

10/16 " 2240'

10/23 " 2490'

10/30 Top chat 2794'

11/6 Drly 2975'

11/13 seg 3005'

11/20 —

11/27 S.D. 3005' T.D.

12/4 — 1/22 —

12/11 — (over)

12/23 —

12/30 —

1930 —

1/8 —

1/15 —

1930

1/29-Top Chat 2794

T.D. 3005'

bad freq. job

Abandoned

11
 Map No. **KANSAS** Sec. 10 Twp. 28 R. 5 ^E
Well No. 1 CovertN. S. Sanford. Company

Contractor

FIRST REPORTS**SECTION PLAT**330 Ft. from N. Line

Ft. from S. Line

330 Ft. from E. Line

Ft. from W. Line

Location ✓

Rig up

Drilling and Remarks:

RECORD

Cased _____ in., _____ ft.

Sand _____

Gas _____

Oil _____

Total Depth _____

PRODUCTION

1st 24 hrs. Nat. _____

1st 24 hrs. after shot _____

Gas _____ Cu. Ft.

Dry Hole _____

Abandoned _____

Date

AUG 28 1929

19

CHAS. L. SHERWOOD

Scout

AUG 28 1929

Map No. **KANSAS** Sec. **10** Twp. **28** R. **5**

Well No. **1** **Covert**

W. G. Sangard. Company

Contractor

COMPLETE

SECTION PLAT

330 Ft. from N. Line

Ft. from S. Line

330 Ft. from E. Line

Ft. from W. Line

ABANDONED

	0		

Location

Rig up

Drilling and Remarks:

Top Chat 2794

**abandoned on
account bad
fishing job.**

RECORD

Cased in, ft.

Sand

Gas

Oil

Total Depth **2005**

PRODUCTION

1st 24 hrs. Nat.

1st 24 hrs. after shot.

Gas Cu. Ft.

Dry Hole

Abandoned ☒

Date

JAN 29 1930

CHAS. L. SHERWOOD

192

Scout