


Section 10 Township 28 Range 5 E

Well No. # 1 Covert

Company Murfin Drlg.

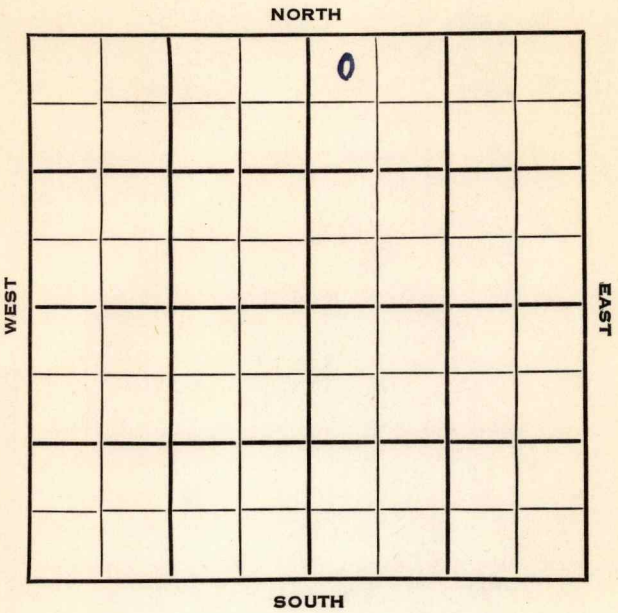

Butler

KANSAS


SEC. 10	TWP. 28	R. 5 E	✓
------------	------------	-----------	---

WELL NO. # 1 Covert FARM

COMPANY Murfin Drlg.

CONTRACTOR

330 Ft. from N. Line
 _____ Ft. from S. Line
 _____ Ft. from E. Line
 330 Ft. from W. Line

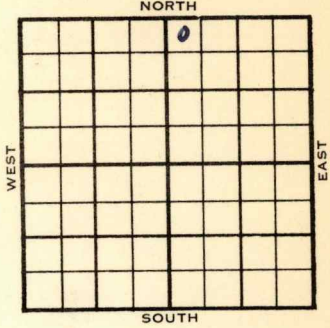

NW NW NE

	ELEVATION	REPORT
1953	1276'	
10/21	MICT	
12/2	Spud 10-25-53	
	D & A TD 3224'	15" @ 53
	13" @ 1010	10" @ 1885
	8" @ 2395	KC 2130 Miss 2725
	B Miss 3045	Viola 3131 Simp dol.
	3152'	Simp. sd. 3159' Arb. 3169'
	TD 3224'	D & A

ABANDONED

