


Section 24 Township 13 Range 30W
Well No. 1 James P. Losey
Company Magnolia Petr.

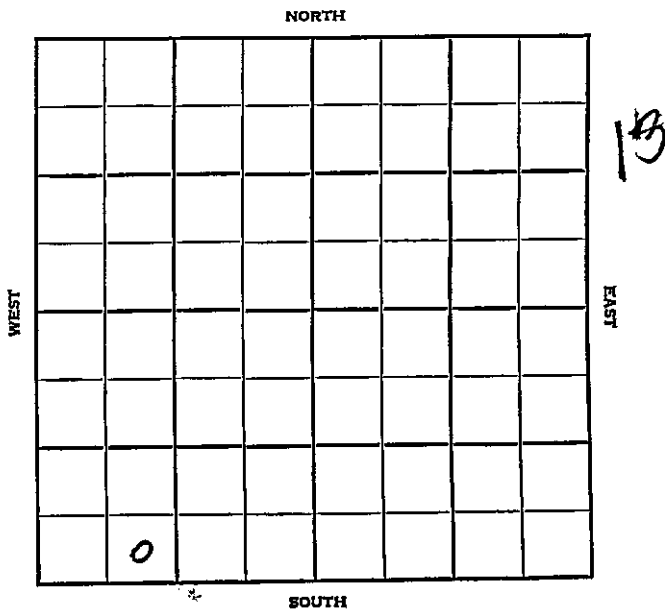

Gove KANSAS

SEC: 24 TWP. 13 R. 30W

WELL NO. 1 James P. Losey FARM
COMPANY

CONTRACTOR Magnolia Petr.


Barnett

Gove Pool
Ft. from N. Line

330 Ft. from S. Line

Ft. from E. Line

990 Ft. from W. Line

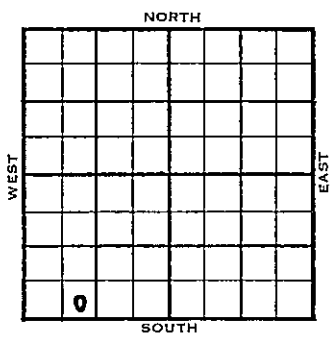

SE SW SW

1955 ELEVATION 2865' REPORT

4/20

S
pud 4-15-55
9" @ 197'
rlg. 2800'

