


DX 78-1 Ellis

KANSAS

Section 24 Township 14 Range 18W

Well No. 1 Brull

Company Transit Corp & Altman Pet

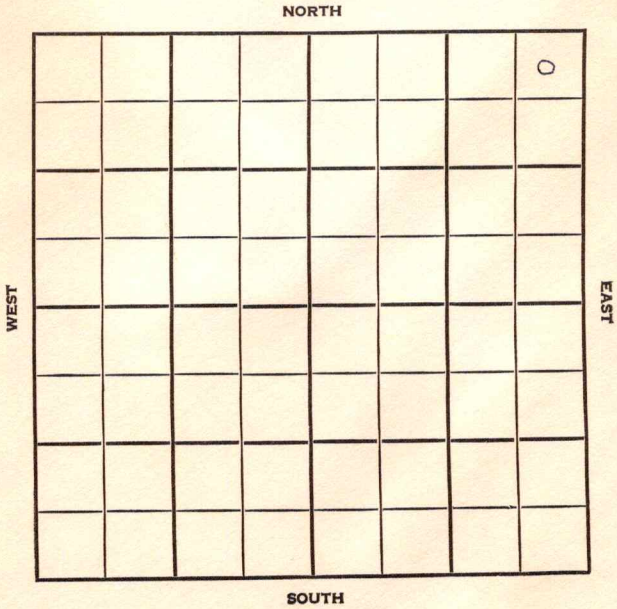

SEC.	TWP.	R.
24	14	18W

WELL NO. #1 Brull FARM

COMPANY Transit Corp & Altman Pet.

CONTRACTOR Transit


Wildcat.

330 Ft. from N. Line

Ft. from S. Line

330 Ft. from E. Line

Ft. from W. Line

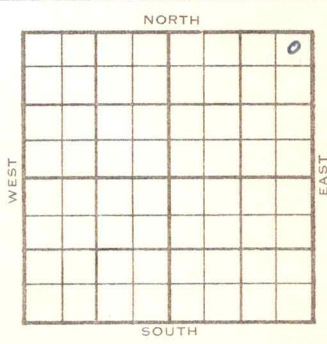

NE NE NE
Texas Ac. Sunray - DHM

1955	ELEVATION	REPORT
	1985'	

4/27 Spud 4-23-55
8" @ 1189'
Anhy 1184'

5/25 Drlg.
Heeb 1985; Tor 3253; Lsg 3280;
Congl 3529; TD 3630; 8" 1189;
DST 3440-60 open 1 hr, rec 5' mud, Off
no log;
D&Z **ABANDONED**

