


Section 11 Township 28 Range 5E

Well No. #1 Crowley

Company Nadel and Gussman

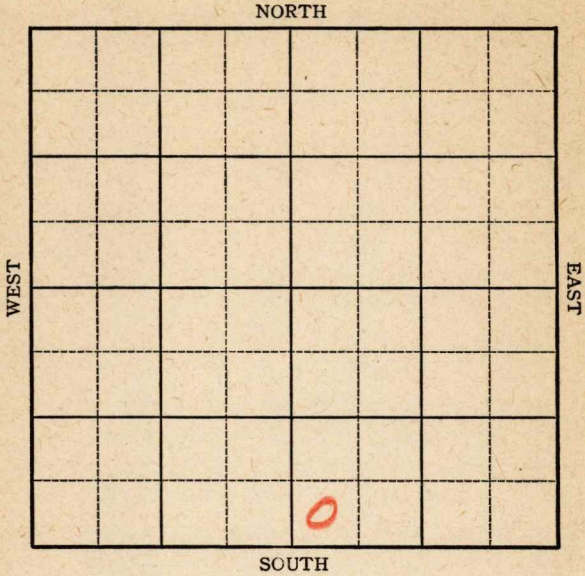



Sec. 11 Twp. 28 R. 5E

Well No. #1 Crowley Farm

Nadel and Gussman Company

Miscellaneous


_____ Ft. from N. Line

330 Ft. from S. Line

_____ Ft. from E. Line

330 Ft. from W. Line

SW SE

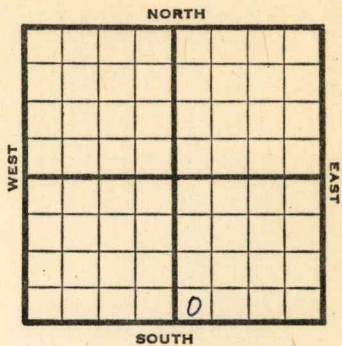

1946 **Elev. 1305'** REPORT

- 1/9 Location
- 1/17 Machine.
- 1/24 Drlg. 200'
- 1/31 15" - 335' 13" - 980'
Drlg. 1250'
- 2/7 10" - 1850' Drlg. 1875'
- 2/14 8" - 2315' Drlg. 2540'
- 2/21 **Bart 2692'** 7" - 2695'
T.D. 2738' **Miss 2731'**
Shot 140 qts. 2700-38' C.O.
H.F.O.
- 2/28 Swab 98 oil & 40 water in 24 hours.
- 3/7 " " "
- 3/14 12" - 960' Drlg. 1405'
- 3/21 10" - 1865'
Drlg. 2050'
- 3/28 **Bart. 2689-93'** T.D.
7" - 2685' RUST.
- 4/4 TD 2700
500' oil 18 hrs.
40 qts. CO
- 4/10 **Bart 2689**
7" @ 2685
TD 2700
Pump 168 Pot.
Grav. 40.7

COMPLETED

KANSAS

Kansas

Pool Name Miscellaneous

Map No. 11 Sec. 11 Twp. 28 R. 5E

Well No. 1 Crowley

Madel & Gussman Company

COMPLETED

SW SE

Contractor

E. 1305
SECTION PLAT

| | | | |
|--|--|--|--|
| | | | |
| | | | |
| | | | |
| | | | |
| | | | |

_____ Ft. from N. Line

330 Ft. from S. Line

_____ Ft. from E. Line

330 Ft. from W. Line

Butler County

Location _____

Rig up _____

Drilling and Remarks:

*Miss 278/
7" C2695*

Pump 100 Pst

35° SW

RECORD

Cased _____ in., _____ ft.

Sand _____

Gas _____

Oil _____

Total Depth 2735

PRODUCTION

1st 24 hrs. Nat. _____

1st 24 hrs. after shot _____

Gas _____ Cu. Ft.

Dry Hole _____

Abandoned _____

Date

MAR 13 1946

19

S. J. LEWIS

Scout

KANSAS

Kansas

Pool Name Miscellaneous

Map No. 11 Sec. 11 Twp. 28 R. 5E

Well No. 1 Crowley

Nadel and Gussman Company

FIRST REPORT

Contractor

SW SE

SECTION PLAT

| | | | |
|--|--|--|--|
| | | | |
| | | | |
| | | | |
| | | | |

Ft. from N. Line

330 Ft. from S. Line

Ft. from E. Line

330 Ft. from W. Line

Butler County

Location X

Rig up _____

Drilling and Remarks:

RECORD

Cased _____ in., _____ ft.

Sand _____

Gas _____

Oil _____

Total Depth _____

PRODUCTION

1st 24 hrs. Nat. _____

1st 24 hrs. after shot _____

Gas _____ Cu. Ft.

Dry Hole _____

Abandoned _____

Date

JAN 9 1946 19

S. J. LEWIS Scout