
Ellis KANSAS

SECTION 20 TOWNSHIP 14 RANGE 18W

WELL NO. #1 Leonhardt

COMPANY Alpine O&R

NORTH NE NE SE

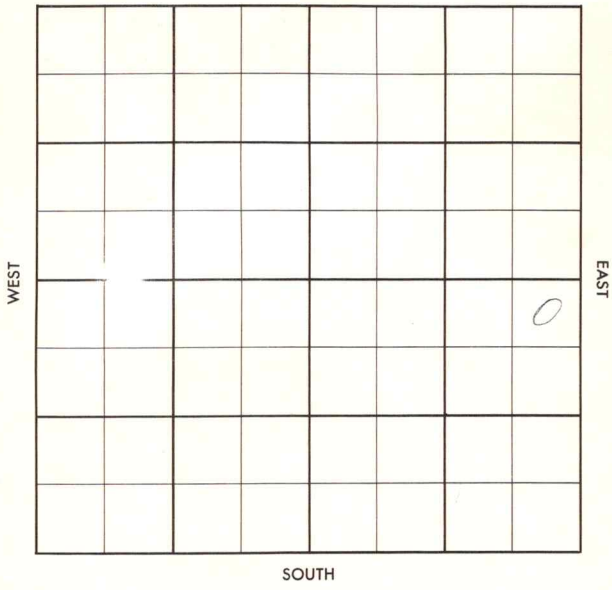

FORM 504-3 SUNRAY

HOT FILE

Ellis KANSAS

SEC.	TWP.	R.
20	14 S	18 W

WELL NO.

1 Leonhardt FARM


COMPANY

Alpine Oil & Royalty Co. Inc.

CONTRACTOR

Quaker Tools

Wildcat

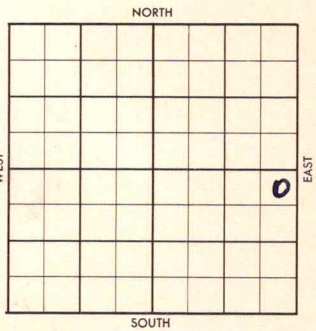

_____ FT. FROM N. LINE

_____ FT. FROM S. LINE

_____ FT. FROM E. LINE

_____ FT. FROM W. LINE

NE NE SE

SDX-DHC-$2500.00 (Lse S-12199) Do not advise Contract Section

	ELEVATION		
1957	2048'	REPORT	(WH7-DC16) ✓

Arbuckle Test appx 3650'

2/21 To be commenced by April 15, 1957
To be completed by May 15, 1957
(See copy DHC Agrt 2-21-57)

3/13 Location (FR Tkt)

4/3 Spud 3-16-57
8-5/8" @ 243 w/150 Anhy 1268'
DST 3370-3410, op 1 hr rec 25' mud.
FP 0-40#. BHP 40#. Cg 3652'
Arb. 3704' RTD 3754' D & A
Tops: Anhy. 1268', H. 3321', Tr. 3340
L. 3368', Cg 3652', Arb. 3704'
TD 3754' D & A (Sct. Comp. Tkt)

ABANDONED ✓

FORM 504-5 SUNRAY

FORM 513 SUNRAY

County Ellis | Elev. 2048 | Co.

Sec. 20 | Twp. 14 | Rge. 18W

Company Alpine O. & R.

Farm Name Leonhardt | No. 1

TOPS	DEPTH	LOG	DATUM
Anh.	1268		
Tp.			
H.	3321		
Tr.	3345		
Dg.			
Bl.			
L.	3368		
[redacted]			
	3652		
K.			
Mz.	DEA		
Mo.			
V.			
S.			
S.			
A	3704		
R.			
Pe.			
G.			
T.D.	3754		

Loc. in Sec. NE NE SE

Geol.

Contr. Quaker Tools | Lse.

Pool Wildcat

ABANDONED

APR 3 '57 0

DHM

No.

Date Comm.

Location MAR 20 '57 X spd 3-16-57

8 5/8 243/150 Anhy 1268 ϕ 1800

MAR 27 '57 X Tops DST 3370-3410 ope 1 hr rec 25' Mud FP 0-40 BHP 40 ϕ 3475 APR 3 '57 X cg 3652 anh 3704 RTD 3754

Sec.

T.

R.

DEA

WILDCAT

FORM 513 SUNRAY

County Ellis Elev.

Sec. 20 Twp. 14 Rge. 18W

Company Alpine O. & R.

Farm Name Leonhardt No. 1

TOPS	DEPTH	LOG	DATUM
Anh.			
Tp.			
H.			
Tr.			
Dg.			
B.L.			
L.			
K.C.			
B.K.C.			
Ce.			
C.			
M.			
M.			
K.			
Mz.			
Mq.			
V.			
S.			
S.			
A			
R.			
P€.			
G.			
T.D.			

Loc. in Sec. NE NE SE

Geol.

Contr. Quaker Tools

Pool Wildcat

FIRST REPORT

WH7-2016 DHM

SDX

MAR 13 57

Date Comm.

Location

14

Co. Lse. No. Sec. T. R.

MAR 13 1957
M. M.