


Section 23 Township 14 Range 18W

Well No. 1 Emery

Company Hanlon & Boyle

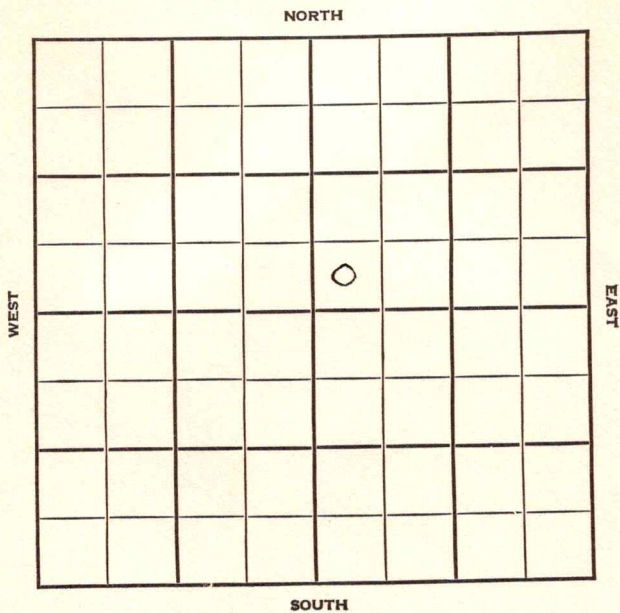

KANSAS

Ellis



Sec. 23 Twp. 14 R. 18W

Well No. #1 Emery Farm

Hanlon & Boyle Company

Wildcat


         Ft. from N. Line

330' Ft. from S. Line

         Ft. from E. Line

330' Ft. from W. Line

SW NE

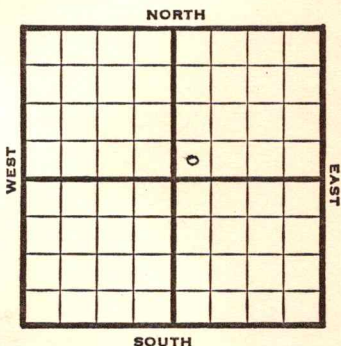

1948

Eli 1984'

REPORT

7/28

8" @ 960'  
Anhy. 1183'  
Topeka 2973'  
Lans. 3295'  
Drlg. 3371'

8/4

Cong 3510'  
Arb. 3630'  
TD 3677'  
Aband.

**ABANDONED**

$$\begin{array}{r} 2973 \\ 1984 \\ \hline - 989 \end{array}$$

$$\begin{array}{r} 3295 \\ 1984 \\ \hline - 1311 \end{array}$$

$$\begin{array}{r} 3510 \\ 1984 \\ \hline - 1526 \end{array}$$

$$\begin{array}{r} 3630 \\ 1984 \\ \hline - 1646 \end{array}$$

$$\begin{array}{r} 3677 \\ 1984 \\ \hline - 1693 \end{array}$$

Ellis County Kansas State

Map No. \_\_\_\_\_ Sec. 23 Twp. 14 R. 18W


Well No. 1 Emery

Hanlon & Boyle Company

FIRST REPORT Contractor

SW NE

SECTION PLAT

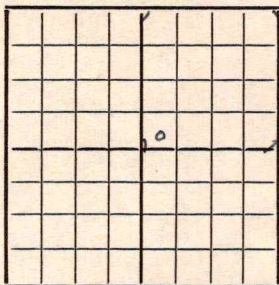

\_\_\_\_\_ Ft. from N. Line

330 Ft. from S. Line

\_\_\_\_\_ Ft. from E. Line


330 Ft. from W. Line

Wildcat

Remarks:

8" @ 960 Anny 1183 Topeka 2973?

Lans, 3295 drlg. 3371

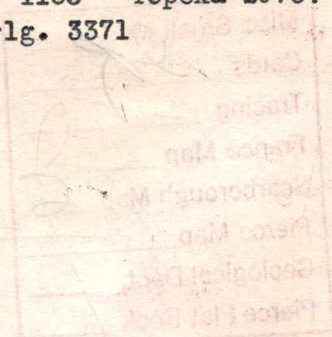

Date JUL 28 1948

Scout S. J. LEWIS

