


Section 23 Township 14 Range 18-W

Well Number #1-Emmery

Company Taylor et al

NORTH

SPECIAL

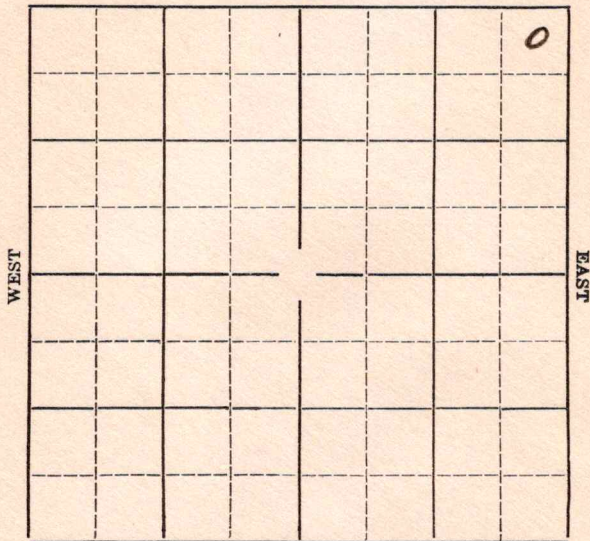

SOUTH

Sec. 23 Twp. 14 R. 18W

Well No. #1 Emmerly Farm
Taylor et al Company


NORTH

330' Ft. from N. Line

_____ Ft. from S. Line

330' Ft. from E. Line

_____ Ft. from W. Line

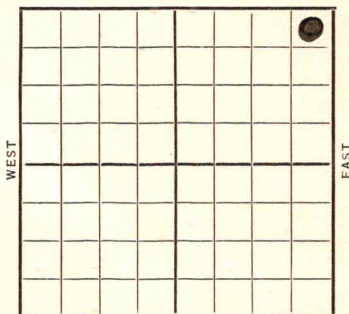

SOUTH

Elev. 1959

Date **SPECIAL** REPORT

8/26 Location.

9/3--

9/10 Rigging up.

9/18 Drlg. 310'.

9/24 15" @ 375'. Drlg. 532'.

10/1 12" @ 793'. Drilling.

10/8 Sh t down.

10/15 10" @ 815'. Drlg. 985'.

10/22 Anhydrate 1162'. set 10".

Drlg. 1165'.

10/29 Drlg. 2060'.

11/6 Run 8" @ 2645

11/12 Lansing 3285 6" @ 3289

11/19 Sil. 3558 84' of 5" liner

T. D. 3570. 200' oil 5½ hrs

27 gravity.

11/27 Pump 40 oil 10 water. 20 hrs.

12/3 Shut down.

12/10 P. B. 3565'. 300' oil 36 hrs.

OVER

3547
1959
1588

3285
1959
1326

3570
1959
1611

1936

12/17 P. B. 3266'. 94 shots.
C.O.

1937

1/6 Sil. 3547' (Corrected).
T. D. 3588'. P. B. 3266'.
94 Shots.
D & A

$$\begin{array}{r} 3588 \\ - 1959 \\ \hline 1629 \end{array}$$

ABANDONED

$$\begin{array}{r} 3266 \\ - 1959 \\ \hline 1307 \end{array}$$

Map No. 71 Sec. 23 Twp. 14 R. 18W

Well No. 1 Emmerly

Taylor & Co Company

Contractor

SPECIAL

SECTION PLAT

| | | | |
|--|--|--|---|
| | | | 0 |
| | | | |
| | | | |
| | | | |

330 Ft. from N. Line

_____ Ft. from S. Line

330 Ft. from E. Line

_____ Ft. from W. Line

FIRST REPORT

Location ✓

Rig up _____

Drilling and Remarks:

RECORD

Cased _____ in., _____ ft.

Sand _____

Gas _____

Oil _____

Total Depth _____

PRODUCTION

1st 24 hrs. Nat. _____

1st 24 hrs. after shot _____

Gas _____ Cu. Ft.

Dry Hole _____

Abandoned _____

Date

AUG 26 1936 19

S. J. LEWIS

Scout

KANSAS

Map No. 71 Sec. 23 Twp. 14 R. 18W

Well No. 1 Emmercy

Taylor & Co Company

Contractor

SECTION PLAT

330 Ft. from N. Line

_____ Ft. from S. Line

330 Ft. from E. Line

_____ Ft. from W. Line

| | | | |
|--|--|--|---|
| | | | 0 |
| | | | |
| | | | |
| | | | |

ABANDONED

Location _____

Rig up _____

Drilling and Remarks:

Oil 3547 connected

P.B 3266

94 Bk & T.

J & H

RECORD

Cased _____ in., _____ ft.

Sand _____

Gas _____

Oil _____

Total Depth 3588

PRODUCTION

1st 24 hrs. Nat. _____

1st 24 hrs. after shot _____

Gas _____ Cu. Ft.

Dry Hole _____

Abandoned _____

Date

JAN 6 1937

19

S. J. LEWIS Scout