


Map No. **KANSAS** Sec. 11 Twp. 28 R. 5E

Well No. 1-Crawley Farm \_\_\_\_\_  
Empire O & R Company \_\_\_\_\_

NORTH

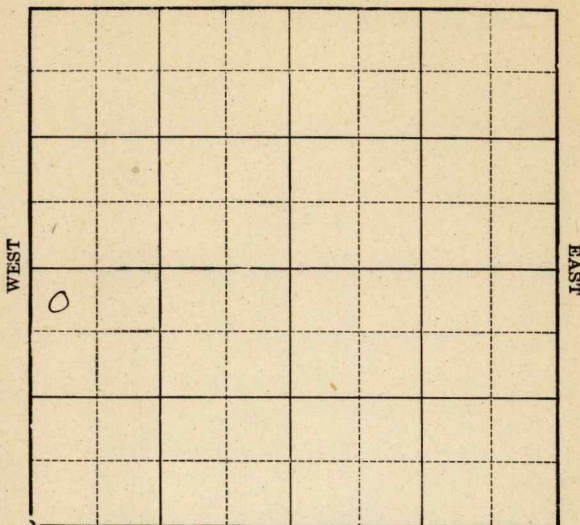

SOUTH

Location \_\_\_\_\_

Drilling Remarks \_\_\_\_\_

Rig Up \_\_\_\_\_

Drilling Remarks \_\_\_\_\_

**RECORD**

Cased \_\_\_\_\_ in. \_\_\_\_\_ ft.

Sand \_\_\_\_\_

Gas \_\_\_\_\_

Oil \_\_\_\_\_

Total Depth \_\_\_\_\_

**PRODUCTION**

1st 24 hrs. Nat. \_\_\_\_\_

1st 24 hrs. after shot \_\_\_\_\_

Gas \_\_\_\_\_ cu. ft.

Dry Hole \_\_\_\_\_

Abandoned \_\_\_\_\_

*Butler*

Map No. **KANSAS** Sec. *11* Twp. *28* R. *5<sup>E</sup>*

Well No. *1* - *Crawley* Farm

*Empire O&G* Company


*330* Ft. from N. Line

\_\_\_\_\_ Ft. from S. Line

\_\_\_\_\_ Ft. from E. Line

*330* Ft. from W. Line

*1930*

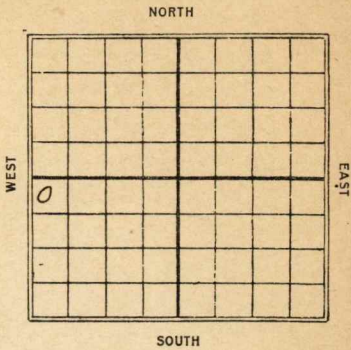

Date

REPORT

Date	REPORT
<i>5/14</i>	<i>Loc</i>
<i>5/21</i>	<i>Bldg rig</i>
<i>5/28</i>	<i>Spdy</i>
<i>6/4</i>	<i>hrlg. 560'</i>
<i>6/11</i>	<i>" 1350'</i>
<i>6/18</i>	<i>" 2175'</i>
<i>6/25</i>	<i>" 2520'</i>
<i>7/2</i>	<i>Top Line 2772'</i>
	<i>hrlg. 2950'</i>
<i>7/9</i>	<i>Top Line 2772-3079</i>
	<i>Ompson 3182-3215</i>
	<i>Top Decline 3215'</i>
	<i>HFW 3230</i>
	<i>TD 3260</i>
	<i>Dry &amp; Abandon</i>

Butler

Map No. **KANSAS** Sec. 11 Twp. 28 R. 5 <sup>E</sup>

Well No. 1

Crawley  
Empire Oil & Refg

Company

Contractor

**FIRST REPORTS**

**SECTION PLAT**

330 Ft. from N. Line

\_\_\_\_\_ Ft. from S. Line

\_\_\_\_\_ Ft. from E. Line

330 Ft. from W. Line

0			

Location

**RECORD**

Rig up \_\_\_\_\_

Drilling and Remarks:

Cased \_\_\_\_\_ in., \_\_\_\_\_ ft.

Sand \_\_\_\_\_

Gas \_\_\_\_\_

Oil \_\_\_\_\_

Total Depth \_\_\_\_\_

**PRODUCTION**

1st 24 hrs. Nat. \_\_\_\_\_

1st 24 hrs. after shot \_\_\_\_\_

Gas \_\_\_\_\_ Cu. Ft.

Dry Hole \_\_\_\_\_

Abandoned \_\_\_\_\_

Date

MAY 14 1930

**CHAS. L. SHERWOOD**

19

Scout

Butler

11 KANSAS Map No. Sec. 11 Twp. 28 R. 5

Well No. 1 Crowley

Empire Oil Co

Company

Contractor

COMPLETE

SECTION PLAT

330 Ft. from N. Line

Ft. from S. Line

Ft. from E. Line

330 Ft. from W. Line

0			

ABANDONED

Location

Rig up

Drilling and Remarks:

Top line 2772-3079  
Simpson 3182-3215  
Top Silc line 3215  
HW 3230

RECORD

Cased in., ft.

Sand

Gas

Oil

Total Depth 3260

PRODUCTION

1st 24 hrs. Nat.

1st 24 hrs. after shot

Gas Cu. Ft.

Dry Hole ✓

Abandoned ✓

Date

JUL 9 1930

CHAS. L. SHERWOOD

Scout