


Section 11 Township 28 Range 5E

Well No. 2 Crowley

Company Hadel & Gussman

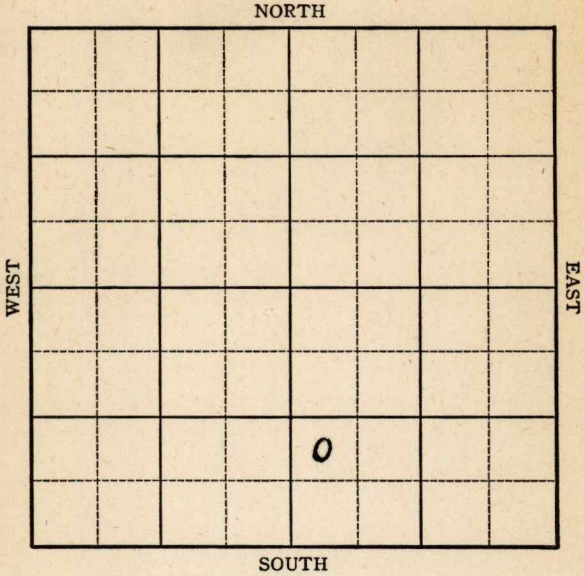

Sec. 11 Twp. 28 R. 5E

Well No. #2 Crowley Farm

Hadel & Gusman Company


Miscellaneous

\_\_\_\_\_ Ft. from N. Line

990 Ft. from S. Line

\_\_\_\_\_ Ft. from E. Line

330 Ft. from W. Line

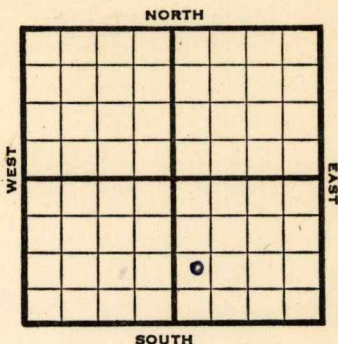

NW SW SE

**Elev. 1316**

**REPORT**

1946

5/29 Mach

~~6/5~~ ~~10" @ 1907~~  
~~Lans 1823~~  
~~KC 2137~~  
~~Drlg. 2275~~

6/5 15" @ 327  
Drlg. 765'

6/12 Drlg 1600'  
13" @ 925'

6/18 Drlg 2343'  
Run 8"

6/26 8" @ 2347'  
**Bart 2739-40 TD**  
7" @ 2721 W<sup>U</sup>C

7/3 **Miss. 2751**  
7" @ 2726  
**Bart 2739**  
40 qts. 2742-2751  
TD 2751'  
Pump 67 oil plus 27 W. Pot.  
Grav. 38.0

**COMPLETED**



**KANSAS**

Kansas Pool Name Miscellaneous

Map No. 11 Sec. 11 Twp. 28 R. 5E

Well No. 2 Crowley

Nadel & Gussman Company

**COMPLETED**

Contractor

NW SW SE

*E. 13 1/2*  
**SECTION PLAT**

		6	

\_\_\_\_\_ Ft. from N. Line

990 Ft. from S. Line

\_\_\_\_\_ Ft. from E. Line

330 Ft. from W. Line

Butler County

Location \_\_\_\_\_

Rig up \_\_\_\_\_

Drilling and Remarks:

*Miss 2751*  
*7" @ 2726*  
*Bar 42789*  
*409 to 2742-51*  
*Pump 67006 + 2744*  
*PT*  
*85° 42'*

**RECORD**

Cased \_\_\_\_\_ in., \_\_\_\_\_ ft.

Sand \_\_\_\_\_

Gas \_\_\_\_\_

Oil \_\_\_\_\_

Total Depth 2751

**PRODUCTION**

1st 24 hrs. Nat. \_\_\_\_\_

1st 24 hrs. after shot \_\_\_\_\_

Gas \_\_\_\_\_ Cu. Ft.

Dry Hole \_\_\_\_\_

Abandoned \_\_\_\_\_

Date

JUL 3 1946 19 S. J. LEWIS Scout