
DX 78-1 Ellis KANSAS

Section 27 Township 14 Range 18 W

Well No. #1 Engle

Company Osage Oil

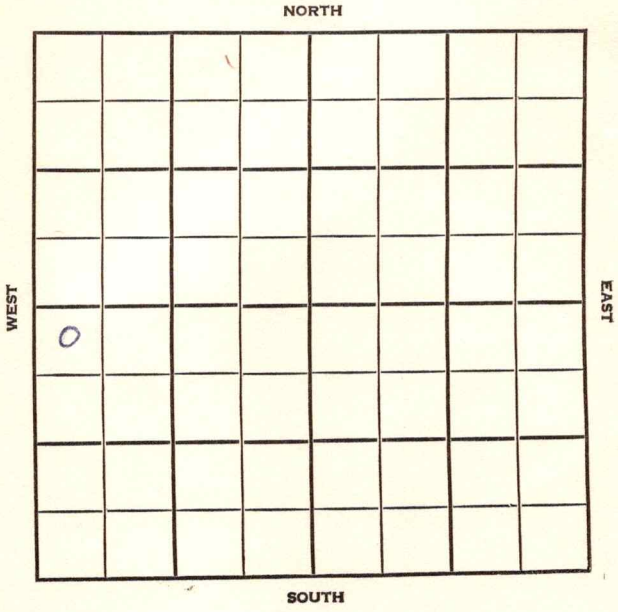

Ellis KANSAS

| SEC. | TWP. | R. |
|---|---|---|
| 27 | 14 | 18W |

WELL NO.

#1 Engle FARM

COMPANY

Osage Oil

CONTRACTOR

Heathman-Seeligson

_____ Ft. from N. Line

_____ Ft. from S. Line

_____ Ft. from E. Line

_____ Ft. from W. Line

NW NW SW




Texas DHM

| 1956 ELEVATION | REPORT |
|---|---|
| ~~2-15~~ 2-15 | Location |

DX-78

FORM 513 REV. SUNRAY

County Ellis Elev. 2263

Sec. 27 Twp. 11 Rge. 18W

Company Osage Oil

Farm Name Engle No. 1

| TOPS | DEPTH | LOG | DATUM |
|---|---|---|---|
| Anh. | 1259 | | |
| Tp. | 3060 | | |
| H. | 3313 | 3312 | |
| Tr. | | 3330 | |
| Dg. | | | |
| Bl. | 3359 | | |
| L. | 3363 | 3356 | 1293 |
| K.C. | | | |
| B.K.C. | | | |
| Ce. | | 3598 | 1535 |
| C. | | | |
| M. | | | |
| M. | | | |
| K. | | | |
| Mi. | | | |
| Me. | | | |
| V. | | | |
| S. | | | |
| S. | | | |
| A | 3689 | 3689 | 1626 |
| R. | | | |
| Pc. | | | |
| G. | | | |
| | 3720 | | |
| TD | | | |

Loc. in Sec. NW NW SW

Geol.

Contr. Heathman-Seeligson

Pool

ABANDONED

MAR

Texas - DHM

Date Comm.

Location FEB 22 '56 2-17-56 8'28

202/170 @ 2350 FEB 29 '56 DST

3346-58 30" rec 13' Md

BHP 121 DST 3332-58 30

rec 75' Md BHP 1090/20"

DST 3386-3433 2hrs rec 80'

MSW FP 0-80 BHP 1090/30"

DST 3520-40 90" rec 20' OCM

+780' FCSW BHP 1130/30

(Over)

DST 3544-60 90" rec 12
SW BHP 1120/30 ×
DST 3625-30 & 90" re
690' SW no press.

K E & A

MAR 19 1956
R. G.

FORM 513 REV. SUNRAY

County Ellis Elev.

Sec. 27 Twp. 14 Rge. 18W

Company Osage Oil

Farm Name Engle No. 1

| TOPS | DEPTH | LOG | DATUM |
|---|---|---|---|
| Anh. | | | |
| Tp. | | | |
| H. | | | |
| Tr. | | | |
| Dg. | | | |
| B.L. | | | |
| L. | | | |
| K.C. | | | |
| B.K.C. | | | |
| Ce. | | | |
| C. | | | |
| M. | | | |
| M. | | | |
| K. | | | |
| Mz. | | | |
| Mo. | | | |
| V. | | | |
| S. | | | |
| S. | | | |
| A | | | |
| R. | | | |
| P€. | | | |
| G. | | | |
| T.D. | | | |

Loc. in Sec. NW NW SW

Geol.

Contr. Heathman-Seeligson

Pool

FIRST REPORT

FEB 15 56

Date Comm.

Texas - DHM

Location

Co. Lease No. Sec. T. R.