


Section 11 Township 28 Range 5E

Well No. #4 Crowley

Company Kewanee Oil

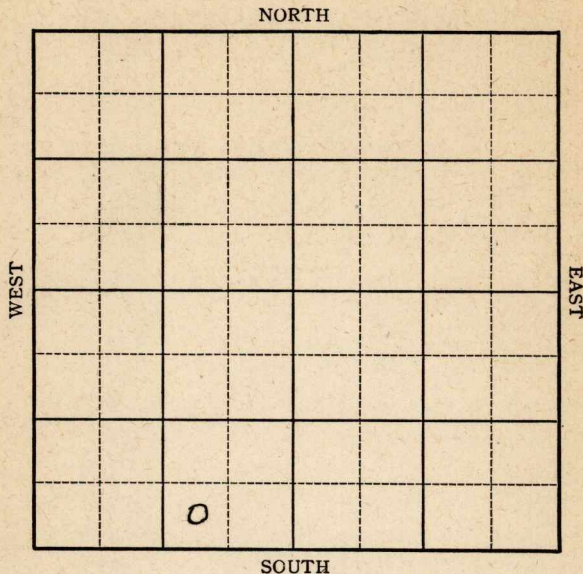

Sec. 11 Twp. 28 R. 5-E

Well No. #4 Crowley Farm

Kewanee Oil Company


Miscellaneous

_____ Ft. from N. Line

330 Ft. from S. Line

990 Ft. from E. Line

_____ Ft. from W. Line

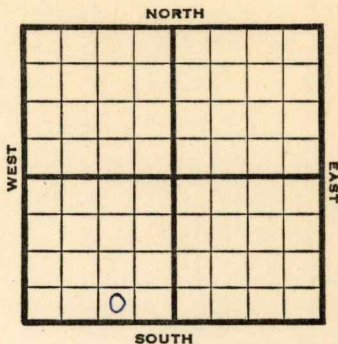

SW SE SW

1946 **Elev. 1311** REPORT

6/19 Location

6/26 "

7/3 15" @ 335
Drlg 340'

7/9 Drlg 1380'
12" @ 950'

7/16 **Lans 1810**
KC 2135
8" @ 1880
Drlg 2290'

7/23 8" @ 2340
Bart 2702
7" @ 2702'
Drlg 2730'

7/30 **Miss 2755**
TD 2756
75 qts 2728-48
Swb 43 oil plus 36 W 24 hrs.

8/7 **Miss. 2755**
7" @ 2702
Bart. 2702
PB 2748
TD 2756
PB 2748
75 qts. 2728-2748
Pump 12 Pot.
Grav. 38.0

COMPLETED

