





Sec. 28 Twp. 14 R. 18 W

Well No. # 1 Stecklin Farm

Lindas Oil Company

Contractor


Wildcat

Ft. from N. Line

330 Ft. from S. Line

330 Ft. from E. Line

Ft. from W. Line

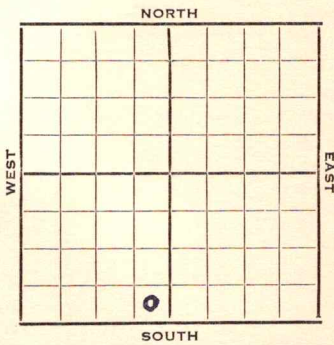

SE SE SW  
Sunray Support

1952 Elev. 2062' REPORT

9/10 Location

9/17 8" @ 241' Anhy 1240'  
Drlg. 1430'

9/24 Topeka 3066' Heeb 3304' Tor 3327'  
B Oread 3343' Lans 3356'  
DST 3418-30, 1 hr, 365' SW  
Drlg. 3480'

10/1

Spud 9-13-52  
D & A TD 3783' 8" @ 241  
Anhy 1240' Top. 3066' Heeb 3304'  
Tor. 3327' B. Oread 3343' Lans 3356'  
DST 3418-30 open 1 hr. rec 365' SW  
B KC 3608' Marm 3623' Cong. 3649'  
Arb. 3690'  
TD 3783' D & A

ABANDONED


County Ellis State Kansas

Sec. 28 (Blk. 14) (Sur. 18W) (Twp.) Map No.

Operator Lindas Oil

Well No. 1 Farm Stecklin

Elev. 2062 Location SE SE SW

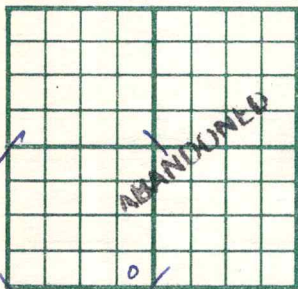

330 Ft. From S Line SW

330 Ft. From E Line Quarter

1st. Report

Completion OCT 1 1952

Remarks Wildcat

Spudding Date 9-13-52

Drlg. Data D & A TD 3783

8" @ 241 Anhy 1240 Top. 3066

Heeb. 3304 Tor. 3327 B. Oread 3343

Lans. 3356 DST 3418-30 open 1 hr.

Rec. 365' sw B KC 3608 Marm. 3623

Cong. 3649 Arb. 3690 TD 3783

D & A

