
Ellis KANSAS

SECTION 32 TOWNSHIP 14 RANGE 18 W

WELL NO. #1 F. Rupp

COMPANY Todd-Rupp-Ferguson

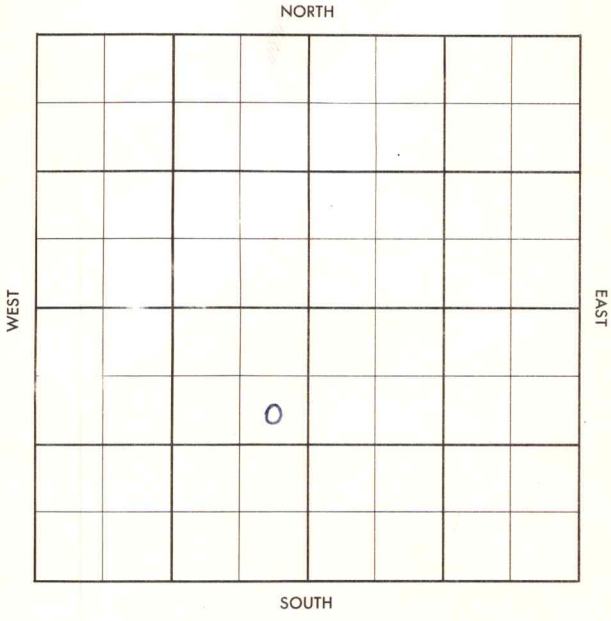

FORM 504-3 SUNRAY

Ellis KANSAS

SEC.	TWP.	R.
32	14	18W

WELL NO.

#1 F. Rupp FARM


COMPANY

Todd-Rupp-Ferguson

CONTRACTOR

Todd

Wildcat

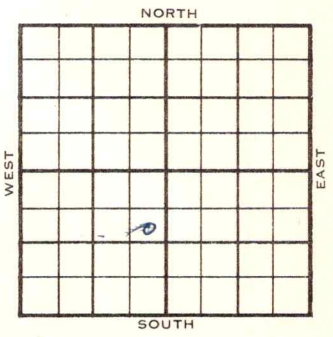

_____ Ft. from N. Line

_____ Ft. from S. Line

_____ Ft. from E. Line

_____ Ft. from W. Line

SE NE SW

1955	ELEVATION 2046' REPORT
11/9	Comm 11-4-55 8" @ 200 Drlg 2515
11-16	DST 3630-61 op 1 hr. rec. 35' mud 375/20" D&A TD 3685' Tops: H. 3287 Tr. 3311 L. 3336 B.K.C. 3571 C. 3615 A 3662'

ABANDONED

DX-78

FORM 513 REV. SUNRAY

County Ellis Elev.

Sec. 32 Twp. 11 Rge. 18W

Company Todd-Rupp-Ferguson

Farm Name F. Rupp No. 1

TOPS	DEPTH	LOG	DATUM
Anh.			
T.P.			
H.			
Tr.			
Dg.			
B.L.			
L.			
K.C.			
B.K.C.			
Ce.			
C.			
M.			
M.			
K.			
Mz.			
Mq.			
V.			
S.			
S.			
A			
R.			
P€.			
G.			
T.D.			

Loc. in Sec. SE NE SW

Geol.

Contr. Todd

Pool Wildcat

FIRST REPORT

NOV 9 '55

Date Comm. 11-4-55

8" @ 200 drlg. 2515

Co. Lse. No. Sec. T. R.

FORM 513 REV. SUNRAY

County Ellis Elev. 2046

Sec. 32 Twp. 11 Rge. 18W

Company Todd-Rupp-Ferguson

Farm Name F. Rupp No. 1

TOPS	DEPTH	LOG	DATUM
Anh.			
Tp.			
H.	3287		1241
Tr.	3311		1265
Dg.			
B.L.			
L.	3336		1290
K.C.			
B.K.C.	3571		1525
Ce.			
C.	3615		1569
M.			
M.			
K.			
Mz.			
Mo.			
V.			
S.			
S.			
A	3662		1616
R.			
P€.			
G.			
T.D.	3685		

Loc. in Sec. SE NE SW

Geol.

Contr. Todd

Pool Wildcat

ABANDONED

Date Comm. 11-4-55 NOV 16 1955

8" @ 200 DST 3630-61 open 1 hr.

Rec. 35' mud 375/20"

D & A

Co. Lse. No. Sec. T. R.