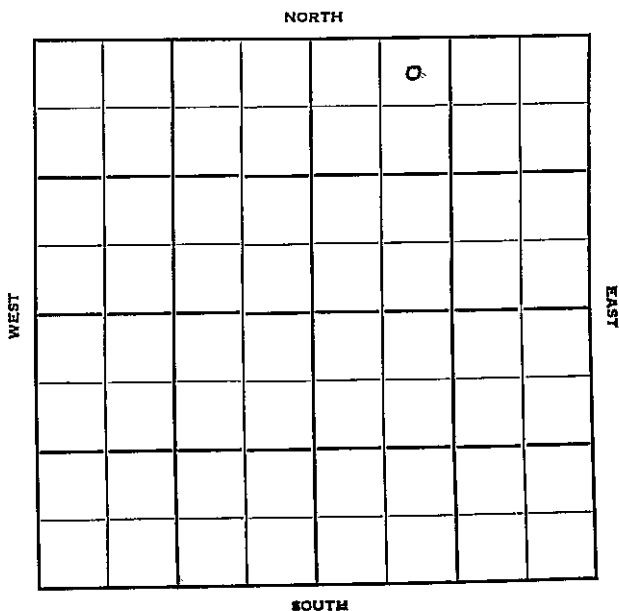


Section 4 Township 13 Range 36-WWell No. #1 SettleCompany Carl Lebsack et al

Logan

KANSAS

Sec. 4 Twp. 13 R. 36W

Well No. #1 Settle Farm

Carl Sebsack et al Company

Contractor


330' Wildcat
Ft. from N. Line

Ft. from S. Line

Ft. from E. Line

990' Ft. from W. Line

NE NW NE

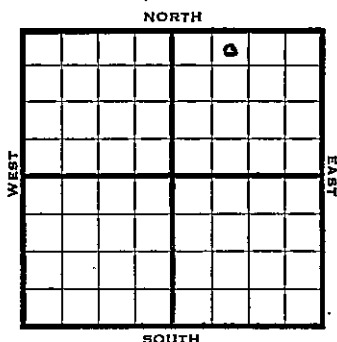

1950 Elev 3012 REPORT

8/16 Location
9/20 Spud 8-28-50
10" @ 135
Lans 3835
DST 3885-3913 opn 1 hr rec 180' socw
Miss 4359
Granite 4601 - No !
TD 4611
D&A

ABANDONED

County Logan State KansasSec. 4 (Blk.) 13 (Sur.) 36W Map No.Operator Carl Lebsack et al.Well No. 1 Farm SettleElev. Location NE NW NE

330 Ft. From N Line NE990 Ft. From W Line Quarter1st. Report AUG 1 6 1950

Completion

Remarks

Spudding Date

Drig. Data WildcatLocation

J. E. TYRA

County Logan State Kansas
 Sec. 4 (Blk.) 13 (Sur.) 36W Map No.
 Operator Carl Lebsack et al.
 Well No. 1 Farm Settle
 Elev. 3012 Location NE NW NE

330 Ft. From N Line NE
990 Ft. From W Line Quarter

1st. Report ~~SEP 20 1950~~

- Completion SEP 20 1950

Remarks

Wildcat

Spudding Date 8-28-50

Drig. Data D & A TD 4611

10" @ 135 Lans. 3835 DST 3885-3913

open 1 hr. Rec. 180' soow Miss. 4359

Granite 4601 TD 4611 D & A