

KANSAS


Butler

Section 11 Township 28 Range 5E

Well No. 3 Hopkins

Company Nadel & Gussman

Misc.

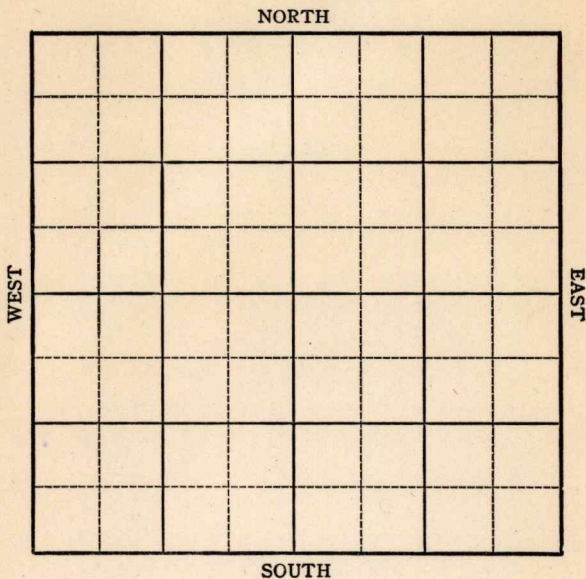

KANSAS

Butler

Sec. 11 Twp. 28 R. 5E ✓

Well No. #3 Hopkins Farm


Nadel & Gussman Company

_____ Ft. from N. Line

330' Ft. from S. Line

920' Ft. from E. Line

_____ Ft. from W. Line

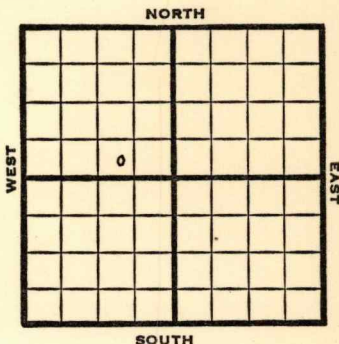

SW SE NW

1949

Elev 1329'

REPORT

- | | |
|------|---|
| 2/23 | Location |
| 3/2 | " |
| 3/8 | " |
| 3/16 | " |
| 3/23 | Mach |
| 3/30 | " |
| 4/6 | Drlg. 275' |
| 4/12 | 15" @ 280'
12" @ 830'
Drlg. 1110' |
| 4/20 | Drlg. 1960' |
| 4/27 | Drlg. 2330' |
| 5/4 | Bart 2736'
5" @ 2724' |
| 5/10 | Miss 2759'
TD 2760' |
| 5/18 | 50 qt CO |
| 5/25 | TD 2760'
Miss 2759'
5 @ 2724'
Pump 35 Oil Pot
38 ^{lb} Gr.
Comp |

COMPLETED

Map No. _____ Sec. 11 Twp. 28 R. 5E

Well No. 3 Hopkins

Nadel & Gussman Company

FIRST REPORT Contractor

SW SE NW

SECTION PLAT

_____ Ft. from N. Line

330 Ft. from S. Line

920 Ft. from E. Line

_____ Ft. from W. Line

Butler County

Location X

Rig up _____

Drilling and Remarks:

RECORD

Cased _____ in., _____ ft.

Sand _____

Gas _____

Oil _____

Total Depth _____

PRODUCTION

1st 24 hrs. Nat. _____

1st 24 hrs. after shot _____

Gas _____ Cu. Ft.

Dry Hole _____

Abandoned _____

Date

FEB 23 1949 19

S. J. LEWIS Scout

Map No. K11 Sec. 11 Twp. 28 R. 5E

Well No. 3 Hopkins

Nadel & Gussman Company

COMPLETE

Contractor

SW SE NW

F 11329

SECTION PLAT

_____ Ft. from N. Line

330 Ft. from S. Line

920 Ft. from E. Line

_____ Ft. from W. Line

Butler County

Location _____

Rig up _____

Drilling and Remarks:

Miss 2708
5' 0 2727
Pump 30 oil
38-0-32

RECORD

Cased _____ in., _____ ft.

Sand _____

Gas _____

Oil _____

Total Depth 2760

PRODUCTION

1st 24 hrs. Nat. _____

1st 24 hrs. after shot _____

Gas _____ Cu. Ft.

Dry Hole _____

Abandoned _____

Date

MAY 25 1949

19

S. J. LEWIS

Scout