

KANSAS


FORM 51 5M PETROL

Ellis

Section 29 Township 14 Range 18-W

Well No. #1 Penney


Company Darby

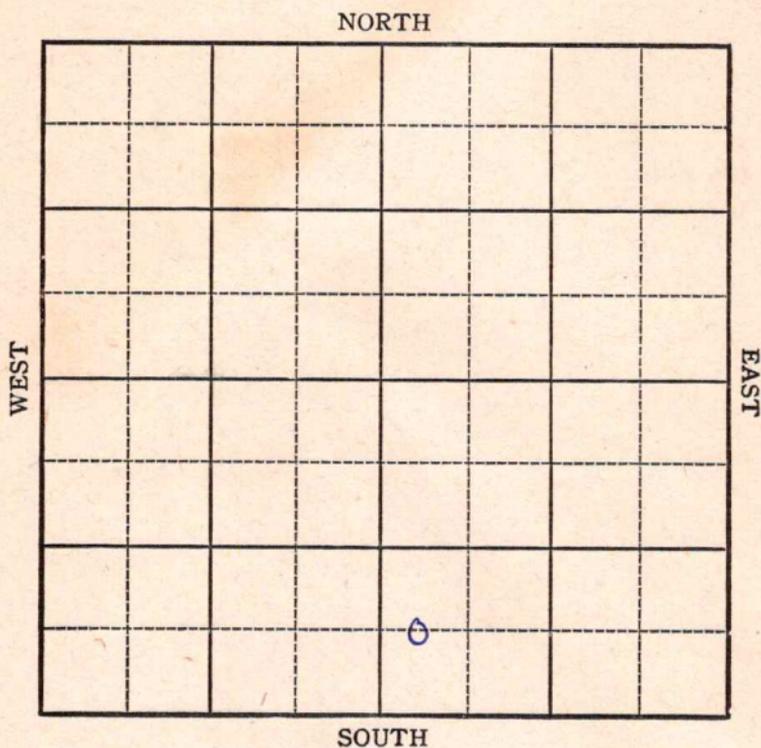

Sec. 29 Twp. 14 R. 18-W

Well No. #1 Penney Farm _____
Darby Company _____

NORTH

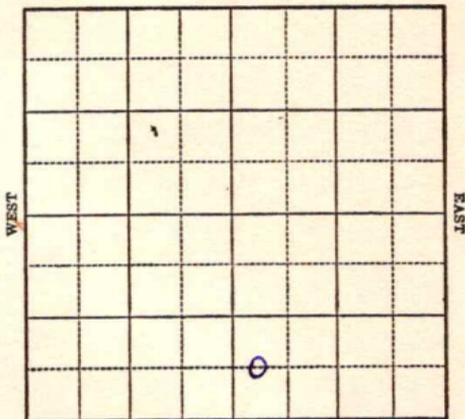

_____ Ft. from N. Line

660 Ft. from S. Line

_____ Ft. from E. Line

330 Ft. from W. Line

Elev. 2054

1943

R E P O R T

10/27 Drlg. 1000'

11/3 10" @ 1151
Anhy 1245
Wraford 2350
Drlg. 2410'

11/10 **Lans 3351**
Cong. 3644
Arb. 3675
T.D. 3714'

ABANDONED

KANSAS

Map No. _____ Sec. 29 Twp. 14 R. 18W

Well No. 1 Penney

Darby Company

FIRST REPORT Contractor

C W L SW SE

SECTION PLAT

		o	

_____ Ft. from N. Line

660 _____ Ft. from S. Line

_____ Ft. from E. Line

330 _____ Ft. from W. Line

Wildcat

Location _____

Rig up _____

Drilling and Remarks:

1000'

RECORD

Cased _____ in., _____ ft.

Sand _____

Gas _____

Oil _____

Total Depth _____

PRODUCTION

1st 24 hrs. Nat. _____

1st 24 hrs. after shot _____

Gas _____ Cu. Ft.

Dry Hole _____

Abandoned _____

Date

OCT 27 1943 19

S. J. LEWIS Scout

KANSAS

Map No. _____ Sec. 29 Twp. 14 R. 18W

Well No. 1 Penney

Darby Company

ABANDONED Contractor

C W L SW SE

SECTION PLAT

_____ Ft. from N. Line

660 Ft. from S. Line

_____ Ft. from E. Line

330 Ft. from W. Line

Wildcat

Location _____

Rig up _____

Drilling and Remarks:

*Loss 335
Cong 3644
Cr 43675*

RECORD

Cased _____ in., _____ ft.

Sand _____

Gas _____

Oil _____

Total Depth 3714

PRODUCTION

1st 24 hrs. Nat. _____

1st 24 hrs. after shot _____

Gas _____ Cu. Ft.

Dry Hole _____

Abandoned _____

Date

NOV 10 1943 19 _____

S. J. LEWIS Scout