

Ellis


KANSAS

SECTION 32 TOWNSHIP 14 RANGE 18W

WELL NO. #1 Rupp

COMPANY Mallonee Drlg. Co.

NORTH

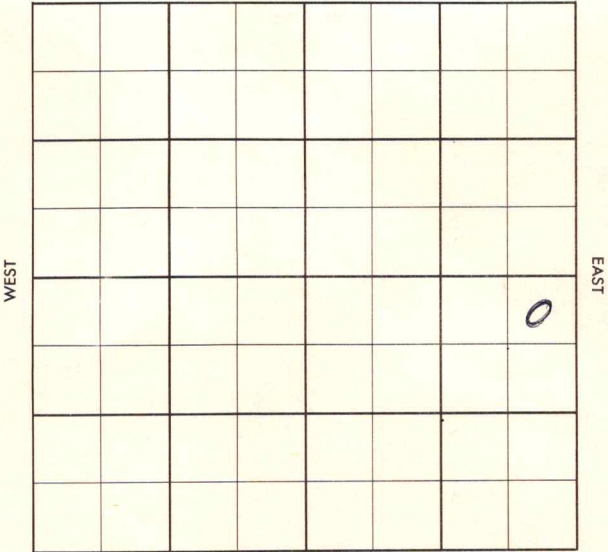

SOUTH



County Ellis Elev. 2051 RB  
 Sec. 32 Twp. 14 Rge. 18W  
 Company Mallonee Drig. Co.  
 Farm Name Rupp No. 1

TOPS	DEPTH	LOG	DATUM	Loc. in Sec.
Anh.	1220			NE NE SE
Tr.				
H.	3280			
Tr.				
Dg.				
Bl.				
L.	3327			Geol.
K.C.				
B.K.C.				Contr.
Ce.				Co. Tools
C.	3617			
M.				Pool
M.				Engel
K.				
Mz.				
Mo.				
V.				
S.				
S.				
A.				
R.				
Pe.				
G.				
TD	3671			

COMPLETE  
 FEB 13 '57

Date Comm. 12-20-56

8" @ 263 w/135, WOC JAN 2 '57 ID 2960  
 JAN 9 '57 X DST 3370-82 or 1hr  
 net 1500' clean oil BHT 1100/20"  
 DST 3401-09 or 1hr 370' SW  
 BHT 720 DST 3515  
 JAN 15 DST 3499-3515 1hr  
 170' OCMW BHT 1170 5/2 3671  
 1125 JAN 29 '57 V ID in JAN 30 '57 CO 48/  
 3370-78 B & 40 Bspk

2 1/2 hrs T E R. FEB 6 '57 Pop.  
P. 50 Bopd no lwr FEB 13 '57  
P. 50 Bopd no lwr