

Ellis


FORM 51

KANSAS

Section 33 Township 14 Range 18W

Well No. #1 Engel

Company Elreco

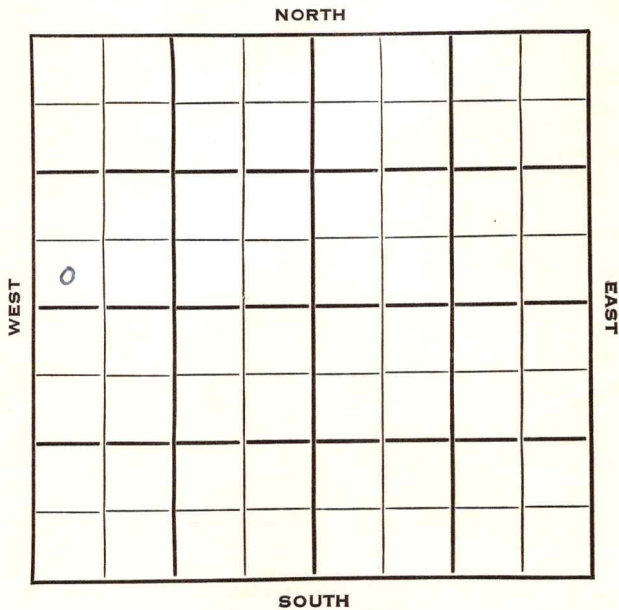

Ellis

KANSAS

SEC.	TWP.	R.
33	14	18W

WELL NO. _____
 COMPANY **1 Engel** FARM

CONTRACTOR **El Reco**


Prime Drlg.

Wildcat
 _____ Ft. from N. Line

330
 _____ Ft. from S. Line

_____ Ft. from E. Line

330
 _____ Ft. from W. Line

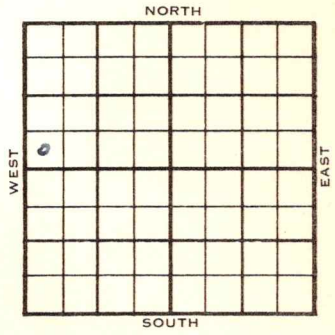

SW SW NW

1953	ELEVATION	REPORT
	2039'	

11/4 Spud 10-29-53
 8" @ 275'
Anhy 1225'
 Drlg. 2675'

11/11 Spud 10-29-53
 D & A
 TD 3704'
 8" @ 275'
**Anhy 1225', Heeb 3270', Tor 3295',
 Lans 3319'**
 DST 3377'-92' opn 1/2 hr, rec 12' wcm
 1075# **Cong 3603', Arb 3654',**
 DST 3657'-69' opn 1/3 hr, Rec 2400' sw
 1130#
 TD 3704'
 D & A

ABANDONED

