

Map No. K Sec. 11 Twp. 28 R. 5

Well No. 1 Weaver Farm


Gardner, Smith & Lippert Company
NORTH

1120 Ft. from N. Line

_____ Ft. from S. Line

_____ Ft. from E. Line

200 Ft. from W. Line

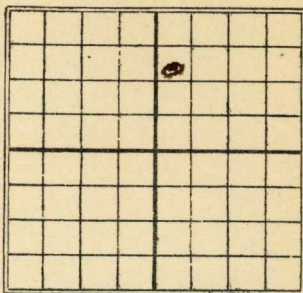

SOUTH

EAST

Date

REPORT

COMPLETED

1/3
1/15

slg 2915'


L. a G. 2930'

Map No. 11 Sec. 11 Twp. 28 R. 5Well No. 1 Weaver FarmGarden, Smith & Gyp companyDate Started _____ Ft. from N 1128 E W2 line

NORTH

Kansas

WEST

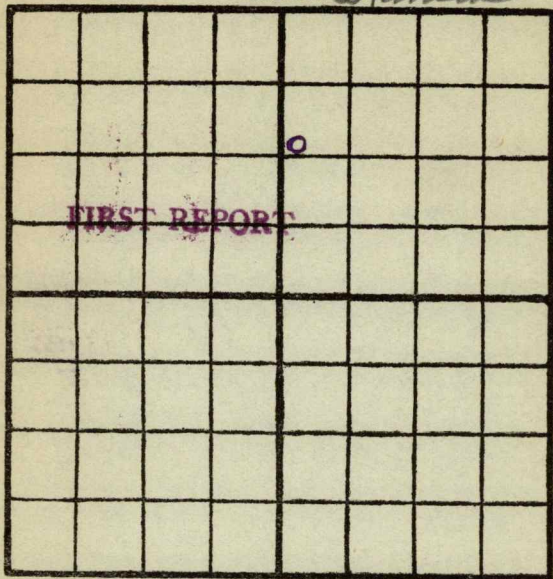

EAST

SOUTH

Cased _____ In. _____ Ft.

Sand _____

Pay { Gas _____
Oil _____

Total Depth _____

Production Remarks

Condition of Well on this date _____

L.O. 2915

M. A. BENEAN

Scout

Map No. K 11 Sec. 11 Twp. 28 R. 3Well No. 1 WeaverGarden & Smith & Gypsy Company

Contractor

Abandoned

SECTION PLAT

1120 Ft. from N. Line

----- Ft. from S. Line

----- Ft. from E. Line

200' Ft. from W. Line

		0	

Location -----

Rig up -----

Drilling and Remarks:

10 & 9, at2930'

RECORD

Cased ----- in., ----- ft.

Sand -----

Gas -----

Oil -----

Total Depth -----

PRODUCTION

1st 24 hrs. Nat. -----

1st 24 hrs. after shot -----

Gas ----- Cu. Ft.

Dry Hole -----

Abandoned -----

Date

1/15 1922 WMB Scout