

KANSAS

Section 34 Township 14 Range 18W

Well No. #1 Engle

Company Helmerich & Payne

"wildcat

NORTH

WEST

EAST

			0				

SOUTH

KANSAS

Sec. 35104 **34** Twp. **14-S** R. **18W**

Well No. **#1 Engle** Farm

Helmerich & Payne Company
Wildcat


330 Ft. from N. Line

Ft. from S. Line

330 Ft. from E. Line

Ft. from W. Line

NE NW

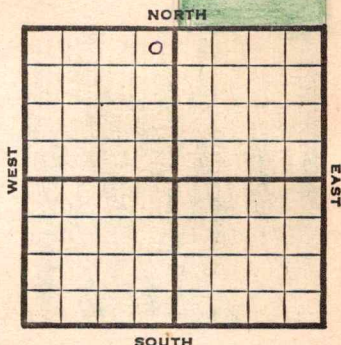

1948

Elev. 2064'

R E P O R T

4/1	Rigging up.	(H&P)
4/5	T.D. 220'	
	10-3/4" set 216' w/150 sacks.	"
4/6	WOC	"
4/7	Drilling 1080' shale.	(Ticket) "
4/8	Drilling 1650' shale.	"
4/10	Drilling 2340'	"
4/11	Drilling 2560'	
4/12	Drilling 2845' Lime, shale	"
4/14	Drilling 3100' lime.	"
4/15	Drilling 3260' lime.	"
4/19	T.D. 3666' lime.	K.C. 3337'
	Taking a D.S.T.	"
4/20	Top Arbuckle.....3653 Total Depth.....3705 Took DST showed water Want to plug well Other companies have agreed	
4/21	Lans. 3337' Cong. 3619' Arbuckle 3655' TD 3709' ABANDONED	


Map No. _____ Sec. 34 Twp. 14 R. 18WWell No. 1 EngleHelmerich & Payne Company

FIRST REPORT

Contractor

NE NW

SECTION PLAT

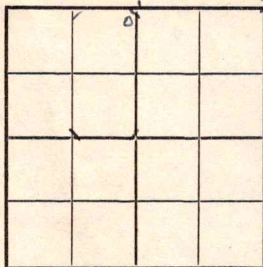330 Ft. from N. Line

_____ Ft. from S. Line

330 Ft. from E. Line

_____ Ft. from W. Line

Ellis County

Location _____

Rig up _____

Drilling and Remarks:

10" @ 216

drlg. 260

RECORD

Cased _____ in., _____ ft.

Sand _____

Gas _____

Oil _____

Total Depth _____

PRODUCTION

1st 24 hrs. Nat. _____

1st 24 hrs. after shot _____

Gas _____ Cu. Ft.

Dry Hole _____

Abandoned _____

Date

APR 7 1948

19

S. J. LEWIS Scout

Map No. 71 Sec. 34 Twp. 14 R. 18W

Well No. 1 Engle

Helmerich & Payne Company

ABANDONED

Contractor

NE NW


E. 2064
SECTION PLAT

330 Ft. from N. Line

 Ft. from S. Line

330 Ft. from E. Line

 Ft. from W. Line

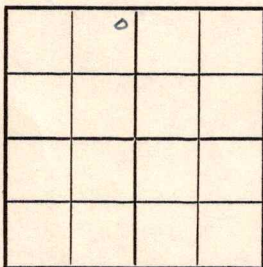

Ellis County

Location

Rig up

Drilling and Remarks:

Lane 3337
Cong 3619
Aug 3655

RECORD

Cased in., ft.

Sand

Gas

Oil

Total Depth 3709

PRODUCTION

1st 24 hrs. Nat.

1st 24 hrs. after shot

Gas Cu. Ft.

Dry Hole

Abandoned

Date

APR 21 1948

19

S. J. LEWIS Scout